

STATE CORPORATION COMMISSION OF KANSAS
OIL & GAS CONSERVATION DIVISION
WELL COMPLETION OR RECOMPLETION FORM
ACO-1 WELL HISTORY
DESCRIPTION OF WELL AND LEASE

Operator: License # 4145
Name Roberts and Murphy, Inc.
Address P. O. Box 7125
1500 North Market
City/State/Zip Shreveport, La. 71137

Purchaser Koch Oil Company
Enron Gas Marketing

Operator Contact Person Brad Cummings
Phone (318) 221-8601

Contractor: License # 5380
Name Eagle Drilling

Wellsite Geologist Lee T. Jenkins
Phone (318) 221-8601

Designate Type of Completion
 New Well Re-Entry Workover
 Oil SWD Temp Abd
 Gas Inj Delayed Comp
 Dry Other (Core, Water Supply etc.)

If OMWO: old well info as follows:
Operator
Well Name
Comp. Date Old Total Depth

WELL HISTORY

Drilling Method:
 Mud Rotary Air Rotary Cable
Feb. 9, 1989 Feb. 21, 1989 3-2-89
Spud Date Date Reached TD Completion Date
6500 6500
Total Depth PBTD

Amount of Surface Pipe Set and Cemented at 866 feet
Multiple Stage Cementing Collar Used? Yes No
If yes, show depth set feet
If alternate 2 completion, cement circulated from feet depth to w/ SX cmt
Cement Company Name
Invoice #
PTI DVA

API NO. 15-033-20,744-0000

County Comanche

SW NW SE 2 35S 20 East
Sec Twp Rge X West

1370 Ft North from Southeast Corner of Section
2590 Ft West from Southeast Corner of Section
(Note: Locate well in section plat below)


Lease Name Box Ranch Well # 15-2

Field Name Wildcat

Producing Formation

Elevation: Ground 1705 KB 1718'

Section Plat

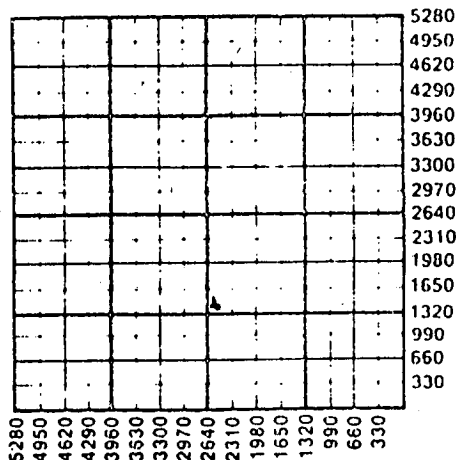

WATER SUPPLY INFORMATION

Disposition of Produced Water: Disposal
Docket # Reoppressuring

Questions on this portion of the ACO-1 call:

Water Resources Board (913) 296-3717
Source of Water:
Division of Water Resources Permit #
Groundwater Ft North from Southeast Corner
(Well) Ft West from Southeast Corner of
Sec Twp Rge East West
Surface Water 0 Ft North from Southeast Corner
(Stream, pond etc) 4620 Ft West from Southeast Corner
Sec Twp Rge East West
Other (explain)
(purchased from city, R.W.D. #)

RECEIVED
STATE CORPORATION COMMISSION
3-2-89
MAR 02 1989
CONSERVATION DIVISION
Wichita, Kansas

INSTRUCTIONS: This form shall be completed in duplicate and filed with the Kansas Corporation Commission, 200 Colorado Derby Building, Wichita, Kansas 67202, within 90 days after completion or recompletion of any well. Rule 82-3-130 and 82-3-107 apply.

Information on side two of this form will be held confidential for a period of 12 months if requested in writing and submitted with the form. See rule 82-3-107 for confidentiality in excess of 12 months. One copy of all wireline logs and drillers time log shall be attached with this form. Submit CP-4 form with all plugged wells. Submit CP-111 form with all temporarily abandoned wells.

All requirements of the statutes, rules and regulations promulgated to regulate the oil and gas industry have been fully complied with and the statements herein are complete and correct to the best of my knowledge.

Signature Brad Cummings

Title Landman Date 2/28/89

Subscribed and sworn to before me this 28th day of February, 1989

Notary Public Robbie S. Coleman

Date Commission Expires My Commission is for Life

K.C.C. OFFICE USE ONLY
 Letter of Confidentiality Attached
 Wireline Log Received
 Drillers Timelog Received
Distribution
 KCC SWD/Rep NGPA
 KGS Plug Other
(Specify)
3-2-89 X

Sec. 2, Twp. 35S, Rge. 20E