


15-195-20252-00-00

STATE OF KANSAS
STATE CORPORATION COMMISSION

Form CP-4

Give All Information Completely
Make Required Affidavit
Mail or Deliver Report to:
Conservation Division
State Corporation Commission
212 No. Market
Wichita, Kansas 67202

WELL PLUGGING RECORD

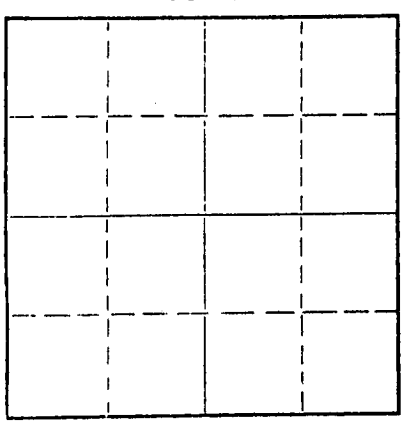

Trego County, Sec. 26 Twp. 12S Rge. 23 (S) x (W)
Location as "NE/CNWxSWx" or footage from lines SW NE SE
Lease Owner Rains & Williamson Oil Co., Inc.
Lease Name Deines Well No. 1
Office Address 435 Page Court, 220 W. Douglas, Wichita, Kansas 67202
Character of Well (completed as Oil, Gas or Dry Hole) Dry Hole
Date well completed 12-1-73 19
Application for plugging filed 12-1-73 19
Application for plugging approved 12-1-73 19
Plugging commenced 12-1-73 19
Plugging completed 12-1-73 19
Reason for abandonment of well or producing formation commercial quantities of oil not found
If a producing well is abandoned, date of last production 19
Was permission obtained from the Conservation Division or its agents before plugging was commenced? yes
Name of Conservation Agent who supervised plugging of this well W. L. Nichols - Morland, Kansas
Producing formation _____ Depth to top _____ Bottom _____ Total Depth of Well 4457 Feet
Show depth and thickness of all water, oil and gas formations.

OIL, GAS OR WATER RECORDS

CASING RECORD

FORMATION	CONTENT	FROM	TO	SIZE	PUT IN	PULLED OUT
				8 5/8"	247'	

Describe in detail the manner in which the well was plugged, indicating where the mud fluid was placed and the method or methods used in introducing it into the hole. If cement or other plugs were used, state the character of same and depth placed, from _____ feet to _____ feet for each plug set.

Plug at 850' w/ 110 sx. cement.
Plug at 275' w/ 50 sx. cement.
Plug, 1/2 sx. hulls at 40' w/ 10 sx. cement.

RECEIVED
STATE CORPORATION COMMISSION
DEC 5 1973
12-05-1973
CONSERVATION DIVISION
Wichita, Kansas

(If additional description is necessary, use BACK of this sheet)
Name of Plugging Contractor Rains & Williamson Oil Co., Inc.
Address 435 Page Court, 220 W. Douglas, Wichita, Kansas 67202

STATE OF KANSAS, COUNTY OF SEDGWICK, ss.
Wilson Rains, President of Rains & Williamson Oil Co., Inc. (owner or operator) of the above-described well, being first duly sworn on oath, says: That I have knowledge of the facts, statements, and matters herein contained and the log of the above-described well as filed and that the same are true and correct. So help me God.

(Signature) Wilson Rains
435 Page Court, 220 W. Douglas, Wichita, Kansas 67202
(Address)

SUBSCRIBED AND SWORN to before me this 3rd day of December, 1973
October 4, 1975
My commission expires _____
JUANITA M. GREEN
SEDGWICK CO., KANSAS

Juanita M. Green
Notary Public.


15-195-20252-00-00

WELL LOG

COMPANY Rains & Williamson Oil Co., Inc.
 FARM Deines NO. 1
 RIG. NO. 4
 TOTAL DEPTH 4457
 COMM. 11-19-73 COMP. 12-1-73
 CONTRACTOR Rains & Williamson Oil Co., Inc.

SEC. 26 T. 12S R. 23W
 LOC. SW NE SE

COUNTY Trego
 KANSAS

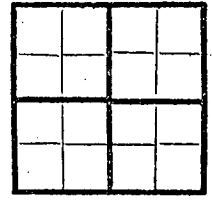

CASINO
 20 10
 15 8 5/8" @ 247' w/ 160 sx. cement, 3% gel, 2% cc.
 12 6
 13 5

ELEVATION 2341 KB
 PRODUCTION D & A

FIGURES INDICATE BOTTOM OF FORMATIONS

Sand and Shale	257
Shale, Sand and Shale	820
Shale and Sand	1530
Shale	1807
Anhydrite	1851
Shale	1875
Shale and Shells	2455
Shale and Lime	2870
Lime and Shale	3175
Shale and Lime	3355
Lime and Shale	3665
Lime	4215
Lime and Chert	4300
Lime	4355
Lime and Chert	4430
Lime	4457
<u>Rotary Total Depth</u>	<u>4457</u>

RECEIVED
 STATE CORPORATION COMMISSION
 DEC 5 1973
 12-05-1973
 CONSERVATION DIVISION
 Wichita, Kansas

State of KANSAS
 County of SEDGWICK ss:

I, Wilson Rains, President of the Rains & Williamson Oil Co., Inc. Company

upon oath state that the above and foregoing is a true and correct copy of the log of the Deines #1 well.

Wilson Rains
 WILSON RAINS



Subscribed and sworn to before me this 3rd day of December 19 73

Juanita M. Green
 NOTARY PUBLIC
 Juanita M. Green

October 4, 1975