

15-195-00268-00-00 H.C.C.


STATE OF KANSAS  
STATE CORPORATION COMMISSION

WELL PLUGGING RECORD

Give All Information Completely  
Make Required Affidavit  
Mail or Deliver Report to:  
Conservation Division  
State Corporation Commission  
211 No. Broadway  
Wichita, Kansas

Trego County. Sec. 34 Twp. 12 Rge. 23 (~~EX~~) (W)  
Location as "NE/CNW%SW%" or footage from lines SW SW SW  
Lease Owner Theodore Gore  
Lease Name Wassinger Well No. 1  
Office Address 400 Brown Bldg. Wichita, Kansas  
Character of Well (completed as Oil, Gas or Dry Hole) dry hole  
Date well completed March 12, 1957 19  
Application for plugging filed March 12, 1957 19  
Application for plugging approved March 12, 1957 19  
Plugging commenced March 12, 1957 19  
Plugging completed March 12, 1957 19  
Reason for abandonment of well or producing formation dry hole

NORTH

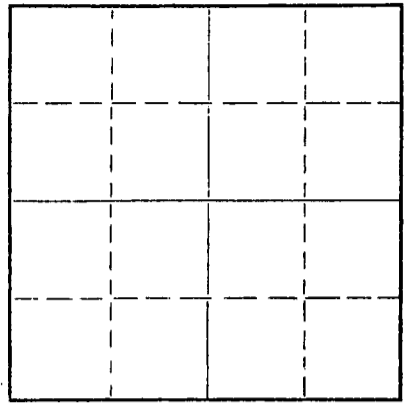

Locate well correctly on above  
Section Plat

If a producing well is abandoned, date of last production \_\_\_\_\_ 19\_\_\_\_  
Was permission obtained from the Conservation Division or its agents before plugging was commenced? Yes

Name of Conservation Agent who supervised plugging of this well Eldon Petty, Hays, Kansas  
Producing formation \_\_\_\_\_ Depth to top \_\_\_\_\_ Bottom \_\_\_\_\_ Total Depth of Well 4600 Feet  
Show depth and thickness of all water, oil and gas formations.

OIL, GAS OR WATER RECORDS

CASING RECORD

FORMATION	CONTENT	FROM	TO	SIZE	PUT IN	PULLED OUT
				8 5/8"	211' w/135 sacks	

Describe in detail the manner in which the well was plugged, indicating where the mud fluid was placed and the method or methods used in introducing it into the hole. If cement or other plugs were used, state the character of same and depth placed, from \_\_\_\_\_ feet to \_\_\_\_\_ feet for each plug set.

First plug set at 205' with 1/2 sack hulls, 20 sacks cement, mud to 40', 1/2 sack hulls, 10 sacks cement. Cemented to bottom of cellar

RECORDED  
STATE CORPORATION COMMISSION  
03-22-1957  
CONS. DIV.

(If additional description is necessary, use BACK of this sheet)  
Name of Plugging Contractor Veeder Supply and Development Co.  
Address Box 201, Cherryvale, Kansas

STATE OF Kansas, COUNTY OF Montgomery, ss.  
C. H. Woods (employee of owner) or ~~owner or operator~~ of the above-described well, being first duly sworn on oath, says: That I have knowledge of the facts, statements, and matters herein contained and the log of the above-described well as filed and that the same are true and correct. So help me God.

(Signature) C. H. Woods  
Cherryvale, Kansas  
(Address)

SUBSCRIBED AND SWORN TO before me this 16th day of March, 19 57

My commission expires July 11, 1960

Lois Lawson  
Notary Public.

PLUGGING  
FILE SEC. 34 T. 12 R. 23W  
BOOK PAGE 149 LINE 28

15-195-00268-00-00

Ralph

Veeder Supply & Dev'l. Co.



Cherryvale, Kansas

Theodore Gore  
Drilled for Veeder Supply & Development Co. Farm Wassinger No. 1 Depth 4600'

Contractor Veeder Supply & Development Co. Pipe 211' 8 5/8" csg. w/135 sacks

Location SW/4 SW/4 SW/4 Sec. 34 Twp. 12S Range 23W

Commenced 2-24-1957 Completed 3-12-1957 County Trego State Kansas

Elevation: 2425 KB

Tops:

Soil shale	0	35	35
Sand shale	35	90	55
Gray shale	90	211	121
Shale and shells	211	710	499
Shale and sand strks	710	1015	305
Shale sand	1015	1120	105
Sand shale	1120	1300	180
Shale red bed	1300	1922	622
Anhydrite	1922	1964	42
Shale shells	1964	2400	436
Shale streak lime	2400	2460	60
Lime and shale	2460	3650	1190
Lime	3650	4336	686
Lime chert	4336	4383	47
Chert lime shale	4383	4437	54
Lime	4437	4480	43
Viola chert	4480	4513	33
Chert lime	4513	4545	32
Arbuckle	4545	4600	55
T. D.	4600		

Anhydrite	1922
Heebner	3774
Toronto	3793
K.C.	3812
Base K.C.	4068
Conglomerate	4333
Miss.	4346
Viola	4465
Simpson	4512*Elec 10
Arbuckle	4548

(No Simpson top called from the samples)

Plugged and abandoned

AFFIDAVIT

STATE OF KANSAS )  
Montgomery County) SS

C. H. Woods, of lawful age, being first duly sworn on oath, deposes and says:

THAT he has read the above drilling log covering the Wassinger #1 Well located in Section 34-12S-23W. Trego County, Kansas, and that the same is true and correct. Further affiant saith not.

THE VEEDER SUPPLY AND DEVELOPMENT CO.

By C. H. Woods  
C. H. Woods

Subscribed and sworn to before me this 16th day of March, 1957.

Oliver Lawson  
Notary Public

My commission expires July 11, 1960.

MAR 22 1957

PLUGGING  
FILE SEC. 34 T. 12 R. 23W  
BOOK PAGE 149 LINE 28