


WELL PLUGGING RECORD

Give All Information Completely  
Make Required Affidavit  
Mail or Deliver Report to:  
Conservation Division  
State Corporation Commission  
211 No. Broadway  
Wichita, Kansas

NORTH

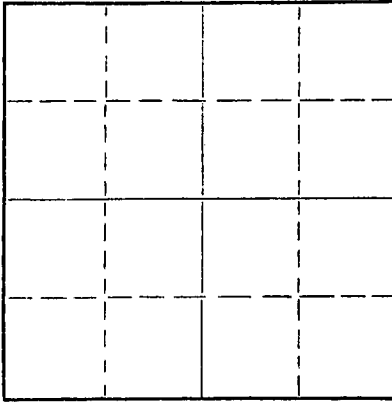

Locate well correctly on above  
Section Plat

Trego County. Sec. 30 Twp. 12S Rge. (E) 23 (W)  
Location as "NE/CNW%SW%" or footage from lines NE NE SW  
Lease Owner Jones, Shelburne & Farmer, Inc.  
Lease Name HEYL Well No. 1  
Office Address Russell, Kansas  
Character of Well (completed as Oil, Gas or Dry Hole) Dry  
Date well completed 6-23 19 56  
Application for plugging filed 6-23 19 56  
Application for plugging approved 6-23 19 56  
Plugging commenced 6-23 19 56  
Plugging completed 6-23 19 56  
Reason for abandonment of well or producing formation Dry

If a producing well is abandoned, date of last production \_\_\_\_\_ 19 \_\_\_\_\_  
Was permission obtained from the Conservation Division or its agents before plugging was commenced? Yes

Name of Conservation Agent who supervised plugging of this well Eldon Petty  
Producing formation \_\_\_\_\_ Depth to top \_\_\_\_\_ Bottom \_\_\_\_\_ Total Depth of Well 4470 Feet  
Show depth and thickness of all water, oil and gas formations. Log TD 4466 - R.T.D.

OIL, GAS OR WATER RECORDS

CASING RECORD

FORMATION	CONTENT	FROM	TO	SIZE	PUT IN	PULLED OUT
				8-5/8	175'	None

Describe in detail the manner in which the well was plugged, indicating where the mud fluid was placed and the method or methods used in introducing it into the hole. If cement or other plugs were used, state the character of same and depth placed, from \_\_\_\_\_ feet to \_\_\_\_\_ feet for each plug set.

1. Filled hole with heavy mud
2. Pushed plug to 170'
3. Dumped 1/2 sack hulls on top of plug
4. Mixed 15 sacks cement and dumped on top of hulls
5. Filled hole to top
6. Pushed plug to 40'
7. Dumped in 1/2 sack hulls
8. Mixed 10 sacks cement and filled hole to top with same.

07-10-1956

(If additional description is necessary, use BACK of this sheet)  
Name of Plugging Contractor Jones, Shelburne & Farmer, Inc.  
Address Russell, Kansas

STATE OF Kansas, COUNTY OF Russell, ss.  
JOHN O. FARMER (owner or operator) of the above-described well, being first duly sworn on oath, says: That I have knowledge of the facts, statements, and matters herein contained and the log of the above-described well as filed and that the same are true and correct. So help me God.  
(Signature) John O. Farmer  
Russell, Kansas (Address)

SUBSCRIBED AND SWORN to before me this 25th day of June, 19 56  
Lucille Kennedy Notary Public.  
My commission expires 10-11-58

PLUGGING  
FILE SEC 30 T 12 R 23W  
BOOK PAGE 75 LINE 12

23W  
 12S, RGE  
 30, TWP  
 Trego  
 1 COUNTY  
 WELL NO. 1  
 HEYL

OPERATOR Jones, Shelburne & Farmer, Inc.


15-195-00171-00-00

FORMATION RECORD

ADDRESS Russell, Kansas

Give detailed description and thickness of all formations drilled through, contents of sand, whether dry, water, oil or gas.

640 Acres  
N

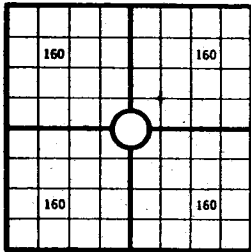

Locate well correctly

COUNTY Trego SEC. 30 TWP. 12S RGE. 23W

COMPANY OPERATING Jones, Shelburne & Farmer, Inc.

OFFICE ADDRESS Russell, Kansas

FARM NAME HEYL WELL NO. 1

DRILLING STARTED 6-8 1956 DRILLING FINISHED 6-23 1956

DATE OF FIRST PRODUCTION \_\_\_\_\_ COMPLETED \_\_\_\_\_

WELL LOCATED NE 1/4 NE 1/4 SW 1/4 North of South

Line and \_\_\_\_\_ ft. East of West Line of Quarter Section

Elevation (Relative to sea level) DERRICK FLOOR 2379 GROUND 2376

CHARACTER OF WELL (Oil, gas or dryhole) Dry

OIL OR GAS SANDS OR ZONES

Name	From	To	Name	From	To
1			4		
2			5		
3			6		

Perforating Record If Any

Shot Record

Formation	From	To	No. of Shots	Formation	From	To	Size of Shot

CASING RECORD

Amount Set				Amount Pulled				Packer Record			
Size	Wt.	Thds.	Make	Ft.	In.	Ft.	In.	Size	Length	Depth Set	Make
8-5/8				175'							

Liner Record: Amount \_\_\_\_\_ Kind \_\_\_\_\_ Top \_\_\_\_\_ Bottom \_\_\_\_\_

CEMENTING AND MUDDING

Size	Amount Set		Sacks Cement	Chemical		Method of Cementing	Amount	Mudding Method	Results (See Note)
	Ft.	In.		Gal.	Make				
8-5/8	175		100						

Note: What method was used to protect sands if outer strings were pulled? \_\_\_\_\_

NOTE: Were bottom hole plugs used? \_\_\_\_\_ If so, state kind, depth set and results obtained \_\_\_\_\_

TOOLS USED

Rotary Tools were used from \_\_\_\_\_ feet to \_\_\_\_\_ Cable tools were used from \_\_\_\_\_ feet to \_\_\_\_\_

\_\_\_\_\_ feet, and from \_\_\_\_\_ feet to \_\_\_\_\_ feet, and from \_\_\_\_\_ feet to \_\_\_\_\_

Type Rig \_\_\_\_\_

INITIAL PRODUCTION TEST

Describe initial test: whether by flow through tubing or casing or by pumping \_\_\_\_\_

Amount of Oil Production \_\_\_\_\_ bbls. Size of choke, if any \_\_\_\_\_ Length of test \_\_\_\_\_ Water

Production \_\_\_\_\_ bbls. Gravity of oil \_\_\_\_\_ Type of Pump if pump is used, describe \_\_\_\_\_

Formation	Top	Bottom	Formation	Top	Bottom
Surface	0	175			
Shale	175	695			
Sand & shale streaks	695	865			
Shale & shells	865	1245			
RedBed	1245	1400			
Sand	1400	1620			
RedBed & shell	1620	1735			
RedBed	1735	1890			
Anhydrite	1890	1930			
Shale	1930	2535			
Shale & lime	2535	2815			
Lime & shale	2815	2910			
Shale & lime	2910	3210			
Lime & shale	3210	3305			
Shale & lime	3305	3465			
Lime & shale	3465	3655			
Lime	3655	3760			
Lime K.C.	3760	4006			
Lime & shale	4006	4150			
Shale & lime	4150	4275			
Shale	4275	4295			
Shale & lime	4295	4335			
Shale Lime & chert	4335	4359			
Chert	4359	4379			
Chert & lime	4379	4418			
Chert, lime & shale	4418	4450			
Arbuckle	4450	4470			
T.D.		4470			

TOPS:  
(ELECTRIC LOG)  
Elevation RB 2381  
Anhydrite 1890  
Heebner 3720  
Toronto 3740  
Lansing 3753  
Base/Kansas City 4008  
Mississippi 4303  
Viola 4357  
Simpson Shale 4398  
Simpson Dolomite 4406  
Arbuckle 4430  
T.D. 4466  
D & A

I, the undersigned, being first duly sworn upon oath, state that this well record is true, correct and complete according to the records of this office and to the best of my knowledge and belief.

*John W. Brown* Pres.  
Name and title of representative of company

Subscribed and sworn to before me this 25th day of June, 1956  
My Commission expires 10-11-58  
*Lucille Finney*  
Notary Public