


Give All Information Completely
Make Required Affidavit
Mail or Deliver Report to:
Conservation Division
State Corporation Commission
212 No. Market
Wichita, Kansas

WELL PLUGGING RECORD

NORTH

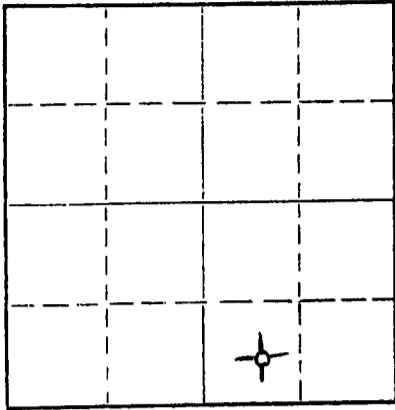

Locate well correctly on above
Section Plat

Trego

County. Sec. 27 Twp. 12 Rge. (E) 24W (W)

Location as "NE/CNW/SW" or footage from lines 150' E C SW SE

Lease Owner Mack Oil Company

Lease Name Neff Well No. 1

Office Address 812 Union Center, Wichita, KS 67202

Character of Well (completed as Oil, Gas or Dry Hole) dry hole

Date well completed 8-8-72 19

Application for plugging filed 8-8-72 19

Application for plugging approved 8-8-72 19

Plugging commenced 8-8-72 19

Plugging completed 8-8-72 19

Reason for abandonment of well or producing formation dry hole

If a producing well is abandoned, date of last production 19

Was permission obtained from the Conservation Division or its agents before plugging was commenced? yes

Name of Conservation Agent who supervised plugging of this well Nichols

Producing formation _____ Depth to top _____ Bottom _____ Total Depth of Well 4540' Feet

Show depth and thickness of all water, oil and gas formations.

OIL, GAS OR WATER RECORDS

CASING RECORD

FORMATION	CONTENT	FROM	TO	SIZE	PUT IN	PULLED OUT
				8 5/8"	209'	

Describe in detail the manner in which the well was plugged, indicating where the mud fluid was placed and the method or methods used in introducing it into the hole. If cement or other plugs were used, state the character of same and depth placed, from _____ feet to _____ feet for each plug set.

Plugged with 110 sx. cement @ 875'
30 sx. cement @ 215'
10 sx. cement @ 40'

RECEIVED
STATE CORPORATION COMMISSION

AUG 11 1972
08-11-1972
CONSERVATION DIVISION
Wichita, Kansas

(If additional description is necessary, use BACK of this sheet)

Name of Plugging Contractor Thomas Drilling Company, Inc.

Address P. O. Box 400, Duncan, OK 73533

STATE OF Kansas, COUNTY OF Sedgwick, ss.


J. Corry Tinsmon (employee of owner) or (owner or operator) of the above-described well, being first duly sworn on oath, says: That I have knowledge of the facts, statements, and matters herein contained and the log of the above-described well as filed and that the same are true and correct. So help me God.

(Signature) J. Corry Tinsmon
812 Union Center, Wichita, KS 67202

(Address)

Subscribed and Sworn to before me this 10th day of August, 1972

Eva Jean Burright Notary Public.

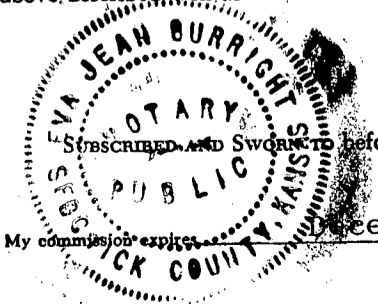

15-195-20231-00-00

RECEIVED
STATE CORPORATION COMMISSION

AUG 11 1972
08-11-1972
CONSERVATION DIVISION
Wichita, Kansas

MACK OIL COMPANY
Duncan, Oklahoma
73533

DRILLERS WELL LOG

#1 Neff 150' E C SW SE - SECTION 27-12S-24W
Trego County, Kansas
Commenced R.D. 8-1-72 Elevation: 2431' K.B., 2424' G.L.
Completed R.D. 8-8-72 Dry & Abandoned
Rotary Total Depth: 4540' Contractor: Thomas Drilling Company

STRATA	DEPTH
Surface soil	0 - 40
Sand	40 - 105
Shale & Shells	105 - 940
Sand	940 - 1000
Shale & Shells	1000 - 1290
Shale & Sand	1290 - 1980
Anhydrite	1980 - 2028
Redbed & Shale	2028 - 2230
Shale	2230 - 2487
Lime	2487 - 2860
Shale & Lime	2860 - 3084
Lime	3084 - 4345
Lime & Shale	4345 - 4463
Chat	4463 - 4540 RTD

I hereby certify that the above is a true and correct log of said well as reflected by the daily drilling reports.

MACK OIL COMPANY

BY J. Corry Tinsmon
J. Corry Tinsmon

Signed and sworn to in my presence
this 10th day of August, 1972, by
J. Corry Tinsmon, representative
of Mack Oil Company.....

Eva Jean Burright
Eva Jean Burright, Notary
Public

Commission expires:
December 1, 1972

