


STATE OF KANSAS  
STATE CORPORATION COMMISSION

WELL PLUGGING RECORD

Give All Information Completely  
Make Required Affidavit  
Mail or Deliver Report to  
Conservation Division  
State Corporation Comm.  
245 North Water  
Wichita, KS 67202

Trego County, Sec. 16 Twp. 12S Rge. 24 E/W  
Location as "NE/CNW/SW" or footage from lines  
NE SW

Lease Owner Gulf Energy & Minerals Company - U.S.  
Lease Name Brandenberg Well No. #1-16  
Office Address 324 N. Robinson, Okla. City, Okla.  
Character of Well (Completed as Oil, Gas or Dry Hole)  
Dry Hole

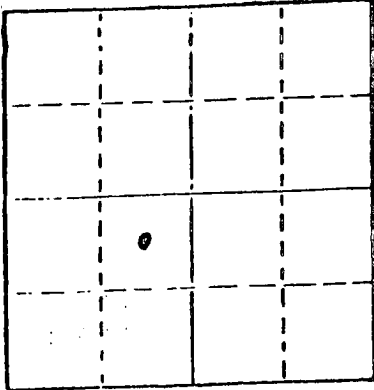

Locate well correctly on above  
Section Plot

Date Well completed 11-20-76 19  
Application for plugging filed 11-20-76 19  
Application for plugging approved 11-20-76 19  
Plugging commenced 11-20-76 19  
Plugging completed 11-20-76 19  
Reason for abandonment of well or producing formation  
Commercial quantities of oil not found.  
If a producing well is abandoned, date of last production 19

Was permission obtained from the Conservation Division or  
its agents before plugging was commenced? Yes

Name of Conservation Agent who supervised plugging of this well Gilbert Balthazor  
Producing formation \_\_\_\_\_ Depth to top \_\_\_\_\_ Bottom \_\_\_\_\_ Total Depth of Well 4475'  
Show depth and thickness of all water, oil and gas formations.

OIL, GAS OR WATER RECORDS

CASING RECORD

FORMATION	CONTENT	FROM	TO	SIZE	PUT IN	PULLED OUT
				8 5/8"	601'	none

Describe in detail the manner in which the well was plugged, indicating where the mud fluid  
was placed and the method or methods used in introducing it into the hold. If cement or other  
plugs were used, state the character of same and depth placed, from \_\_\_\_\_ feet to  
\_\_\_\_\_ feet for each plug set.

RECEIVED  
STATE CORPORATION COMMISSION

- Plug @ 4002' w/50 sx.
- Plug @ 2017' w/50 sx.
- Plug @ 946' w/70 sx.
- Plug @ 316' w/20 sx.
- Plug @ 40' w/10 sx. solid bridge

DEC 20 1976  
12-20-1976  
CONSERVATION DIVISION  
Wichita, Kansas

(If additional description is necessary, use BACK of this sheet)

Name of Plugging Contractor Rains & Williamson Oil Co., Inc.

STATE OF Kansas COUNTY OF Sedgwick, ss.  
Wilson Rains, President of Rains & Williamson Oil Co., Inc. (employee of owner) or (owner or operator)  
of the above-described well, being first duly sworn on oath, says: That I have knowledge of  
the facts, statements, and matters herein contained and the log of the above-described well  
as filed and that the same are true and correct. So help me God.

(Signature) Wilson Rains  
435 Page Court, 220 W. Douglas, Wichita  
(Address) Ks.

SUBSCRIBED AND SWORN TO before me this 23 day of November, 1976



Juanita M. Green  
Juanita M. Green Notary Public.

15-195-20388-00-00


# WELL LOG

COMPANY Gulf Energy & Minerals Company - U.S. SEC. 16 T. 12S R. 24W  
LOC. NE SW  
FARM Brandenburg NO. #1-16

RIG. NO. #2  
TOTAL DEPTH 4475'  
COMM. 11-9-76

COMP. 11-20-76

COUNTY Trego  
KANSAS

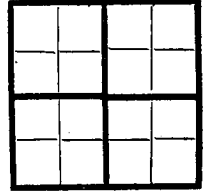

CONTRACTOR Rains & Williamson Oil Co., Inc.

### CASING

20 10  
15 8 5/8" @601' w/150 sx. Class A, 16% gel, 3% salt and 2/10 of 1% CFR2 and  
12 6 100 sx. Class A, 3% cc.  
13 5

PRODUCTION D&A

FIGURES INDICATE BOTTOM OF FORMATIONS

Sand & Clay	110
Blue Shale	615
Shale	783
Sand & Shale	875
Shale	925
Sand	1085
Shale	3485
Shale & Lime	3830
Shale & Lime	3930
Lime	4475
<u>ROTARY TOTAL DEPTH</u>	<u>4475</u>

RECEIVED  
STATE CORPORATION COMMISSION  
DEC 20 1976  
12-20-1976  
CONSERVATION DIVISION  
Wichita, Kansas

State of Kansas  
County of Sedgwick ss:

I, Wilson Rains, President of the Rains & Williamson Oil Co., Inc. Company

upon oath state that the above and foregoing is a true and correct copy of the log of the Brandenberg #1-16 well.

Wilson Rains  
Wilson Rains

Subscribed and sworn to before me this 23 day of November 19 76

My Commission Expires: 10-4-79

Juanita M. Green  
NOTARY PUBLIC  
Juanita M. Green

