


STATE OF KANSAS  
STATE CORPORATION COMMISSION

WELL PLUGGING RECORD

Give All Information Completely  
Make Required Affidavit  
Mail or Deliver Report to  
Conservation Division  
State Corporation Comm.  
245 North Water  
Wichita, KS 67202

Ford County, Sec. 21 Twp. 27S Rge. 22 E/W  
Location as "NE/CNW/SW" or footage from lines  
C NE SE

Lease Owner Imperial Oil Company  
Lease Name Miller A AUB KA Well No. 1-21  
Office Address 720 Fourth Financial Center; Wichita, KS 67202  
Character of Well (Completed as Oil, Gas or Dry Hole)

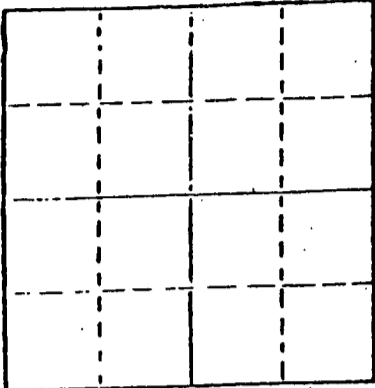

Dry Hole  
Date Well completed 09-21 19 80  
Application for plugging filed 09-21 19 80  
Application for plugging approved 09-21 19 80  
Plugging commenced 09-21 19 80  
Plugging completed 09-21 19 80  
Reason for abandonment of well or producing formation

Dry Hole  
If a producing well is abandoned, date of last production 19

Was permission obtained from the Conservation Division or its agents before plugging was commenced? Yes

Name of Conservation Agent who supervised plugging of this well Clarence Thomas  
Producing formation Depth to top Bottom Total Depth of Well 5188  
Show depth and thickness of all water, oil and gas formations.

OIL, GAS OR WATER RECORDS

CASING RECORD

FORMATION	CONTENT	FROM	TO	SIZE	PUT IN	PULLED OUT
				8 5/8	622	

Describe in detail the manner in which the well was plugged, indicating where the mud fluid was placed and the method or methods used in introducing it into the hold. If cement or other plugs were used, state the character of same and depth placed, from feet to feet for each plug set.

- 60 sacks @ 640'
- 10 sacks @ 40'
- 5 sacks in the rathole
- 5 sacks in the mousehole

RECEIVED  
STATE CORPORATION COMMISSION

10-03-80  
OCT - 3 1980

(If additional description is necessary, use BACK of this sheet)

Name of Plugging Contractor Eagle Drilling, Inc.

CONSERVATION DIVISION  
Wichita, Kansas

STATE OF Kansas COUNTY OF Sedgwick, ss.

Robert L. Eisel (employee of owner) or (owner or operator)


of the above-described well, being first duly sworn on oath, says: That I have knowledge of the facts, statements, and matters herein contained and the log of the above-described well as filed and that the same are true and correct. So help me God.

(Signature) Robert L. Eisel  
260 N. Rock Road Suite 210 Wichita, KS 67206  
(Address)

SUBSCRIBED AND SWORN TO before me this 29th day of September, 1980

Sharon M. Lewis  
Sharon M. Lewis Notary Public.

My commission expires Aug. 13, 1983

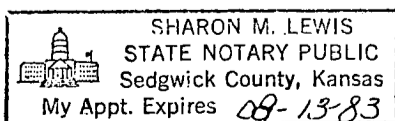

DRILLER'S LOG

Operator: Imperial Oil Company  
Lease Name: Miller #1-21  
Spot Location: C NE SE  
Sec. 21-27S-22W  
County, State: Ford County, Kansas

Commenced: 09-10-80  
Completed: 09-22-80

Surface Casing: Ran 14 joints of 8 5/8" 24 lb.  
Set at 622'. Cemented w/325 sacks Light; 3% cc.  
Followed w/125 sacks Common; 3% cc. Plug down  
at 9:15 p.m. Cement did not circulate. Gravel  
packed w/6 yards.

FORMATION

DEPTH

<u>Red Bed &amp; Clay</u>	<u>0 - 728</u>
<u>Shale &amp; Shells</u>	<u>728 - 1014</u>
<u>Red Bed &amp; Shale</u>	<u>1014 - 1198</u>
<u>Shale &amp; Shells</u>	<u>1198 - 1500</u>
<u>Red Bed, Shale &amp; Lime</u>	<u>1500 - 1940</u>
<u>Shale &amp; Shells</u>	<u>1940 - 2305</u>
<u>Shale &amp; Lime</u>	<u>2305 - 4080</u>
<u>Lime &amp; Shale</u>	<u>4080 - 4285</u>
<u>Lime</u>	<u>4285 - 4510</u>
<u>Lime &amp; Shale</u>	<u>4510 - 4686</u>
<u>Lime</u>	<u>4686 - 5188</u>
	<u>TD - 5188</u>

RECEIVED  
STATE CORPORATION COMMISSION  
OCT - 3 1980  
CONSERVATION DIVISION  
Wichita, Kansas

I do hereby certify that the foregoing statements are true and correct to the best of my knowledge and belief.

EAGLE DRILLING, INC.  
*Robert L. Eisel*  
Robert L. Eisel  
Vice-President

STATE OF KANSAS )  
COUNTY OF SEDGWICK ) ss:

Subscribed and sworn to before me this 29th day of September, 1980.

SHARON M. LEWIS  
STATE NOTARY PUBLIC  
Sedgwick County, Kansas  
My Appt. Expires 08-13-83

My appointment expires; August 13, 1983  
Notary Public *Sharon M. Lewis*  
Sharon M. Lewis