


WELL PLUGGING RECORD

Give All Information Completely  
Make Required Affidavit  
Mail or Deliver Report to:  
Conservation Division  
State Corporation Commission  
800 Bittling Building  
Wichita, Kansas

NORTH

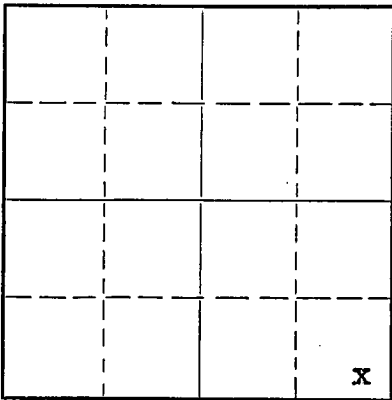

Locate well correctly on above  
Section Plat

Thomas County. Sec. 1 Twp. 10S Rge. 31 (XX W (W))  
Location as "NE/CNW $\frac{1}{4}$ SW $\frac{1}{4}$ " or footage from lines S $\frac{1}{2}$  SE SE  
Lease Owner National Associated Petroleum Co.  
Lease Name Ostmeyer Well No. #1  
Office Address Ritz, Bldg. Tulsa, Okla.  
Character of Well (completed as Oil, Gas or Dry Hole)  
Date well completed  
Application for plugging filed Oct. 22, 19 51  
Application for plugging approved 19  
Plugging commenced Nov. 9, 19 51  
Plugging completed Nov. 13, 19 51  
Reason for abandonment of well or producing formation

If a producing well is abandoned, date of last production 19  
Was permission obtained from the Conservation Division or its agents before plugging was commenced? Yes

Name of Conservation Agent who supervised plugging of this well Eldon Petty  
Producing formation Depth to top Bottom Total Depth of Well 4909 Feet  
Show depth and thickness of all water, oil and gas formations.

OIL, GAS OR WATER RECORDS

CASING RECORD

Formation	Content	From	To	Size	Put In	Pulled Out
				5 $\frac{1}{2}$ "	4340'	2720.35'
				10-3/4"	290'	None

Describe in detail the manner in which the well was plugged, indicating where the mud fluid was placed and the method or methods used in introducing it into the hole. If cement or other plugs were used, state the character of same and depth placed, from feet to feet for each plug set.

Set a Brush Plug at 4120 ft.  
Put in 20 ft. of Rock to 4100 ft.  
Mixed & Dumped five (5) Sacks of Cement.  
Pumped Mud Laden Fluid into hole.  
Bailed out Mud to bottom of surface casing  
Set a brush plug at 280 ft.  
Dumped 20 sacks of cement into hole.  
Pumped mud laden fluid into hole.  
Poured 10 sacks of cement on top.

11-24-51

Name of Plugging Contractor General Casing Pulling Co. (Okla. Corp. Permit # 158)  
Address P.O. Box 4387 1319 SE 29th St. Okla. City 9, Okla.

STATE OF Oklahoma, COUNTY OF Tulsa, ss.  
C. Edwin Mohler (employee of owner) or (Notary Public) of the above-described well,


being first duly sworn on oath, says: That I have knowledge of the facts, statements, and matters herein contained and the log of the above-described well as filed and that the same are true and correct. So help me God.

(Signature) C. Edwin Mohler, Chief Geologist  
5th Floor Ritz Bldg. - Tulsa, Oklahoma (Address)

SUBSCRIBED AND SWORN TO before me this 23rd day of November, 19 51

Sara L. Marsh Notary Public.

My commission expires December 15, 1952

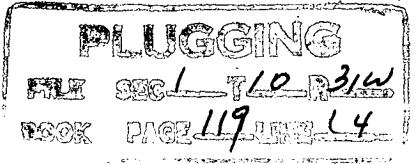

15-193-00040-0000

WELL LOG

National Associated Petroleum Co.  
502 Ritz Building  
Tulsa, Oklahoma  
Ostmeyer #1

SE 1/4 SE 1/4 SE 1/4  
Section 1-T10S-R31W  
Thomas County, Kansas

Total Depth: 4905'  
Comm: 7-25-51 Ccmp: 8-26-51  
Contractor: J. D. Ferrell Drilling Co., Inc.  
Rotary: 0 - 4905'

Elevation: 2975 D.F.

Casing Record: 292.65 - 10 3/4" surface casing cemented w/175 sax bulk cement;  
ciment circulated.  
4345.66 - 5 1/2" casing cemented with 300 sax bulk cement.

Figures Indicate Bottoms of Formations:

Clay	15
Sand and Shale	100
Sand	180
Shale	430
Shale and Shells	1615
Sand	1810
Shale and Sand	1972
Lime	2050
Anhydrite	2080
Red Bed and Shale	2485
Red Bed	2545
Anhydrite	2580
Red Bed and Shale	3040
Lime and Shale	3115
Lime, Shale and Red Bed	3225
Red Bed and Shale	3370
Lime and Shale	3645
Lime	4348
Shale and Lime	4547
Lime	4800
Lime and Shale	4860
Lime	4905

We hereby certify this to be a correct and accurate log of the above described well as shown on the Daily Drilling Reports.

J. D. Ferrell Drilling Company, Inc.

By: J. J. Lenoir

Subscribed and sworn to before me this 19 day of September, 1951.

Wm Gansell  
Notary Public

My commission expires My Commission Expires July 27, 1952.

**PLUGGING**  
FILE SEC L T 10 R 31W  
BOOK PAGE 119 LINE 14