


15-193-00016-0000

STATE OF KANSAS
STATE CORPORATION COMMISSION

Give All Information Completely
Make Required Affidavit
Mail or Deliver Report to:
Conservation Division
State Corporation Commission
800 Bitting Building
Wichita, Kansas

WELL PLUGGING RECORD

Thomas County, Sec. 1 Twp. 10 S Rge. (E) 31 (W)
Location as "NE/CNW/SW" or footage from lines NE NE SE
Lease Owner Herndon Drilling Company
Lease Name OSTMEYER Well No. 1
Office Address Drawer 489, Tulsa, Oklahoma
Character of Well (completed as Oil, Gas or Dry Hole) Dry hole
Date well completed 1-9 1953
Application for plugging filed 1-9 1953
Application for plugging approved 1-9-53 1953
Plugging commenced 1-9 1953
Plugging completed 1-9 1953
Reason for abandonment of well or producing formation Dry hole

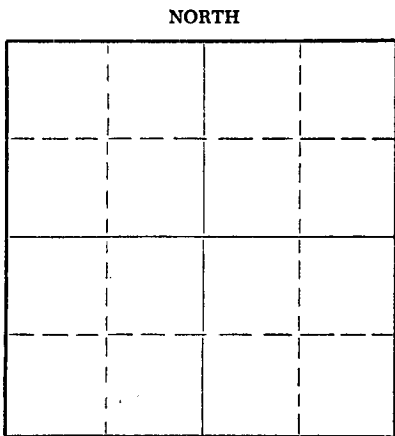

Locate well correctly on above
Section Plat

If a producing well is abandoned, date of last production 19
Was permission obtained from the Conservation Division or its agents before plugging was commenced? Yes

Name of Conservation Agent who supervised plugging of this well Eldon Petty
Producing formation Depth to top Bottom Total Depth of Well 4710 Feet
Show depth and thickness of all water, oil and gas formations.

OIL, GAS OR WATER RECORDS

CASING RECORD

FORMATION	CONTENT	FROM	TO	SIZE	PUT IN	PULLED OUT
				10-3/4	240	None

Describe in detail the manner in which the well was plugged, indicating where the mud fluid was placed and the method or methods used in introducing it into the hole. If cement or other plugs were used, state the character of same and depth placed, from feet to feet for each plug set.

Hole filled with mud to 230 ft. Plug set at 230 ft. Hole bridged at 230 ft. Pumped 20 sacks cement through drill pipe on bridge. Filled with mud to 30 ft. below cellar. Bridge and plug set at 30 ft. Filled with cement to bottom of cellar

Cementing done by Halliburton

1-20-53
CONS. DIV.
WICHITA, KANSAS

(If additional description is necessary, use BACK of this sheet)

Name of Plugging Contractor Herndon Drilling Company
Address Drawer 489, Tulsa, Oklahoma

STATE OF Oklahoma, COUNTY OF Tulsa, ss.
W G. Prather (employee of owner) or (owner or operator) of the above-described well, being first duly sworn on oath, says: That I have knowledge of the facts, statements, and matters herein contained and the log of the above-described well as filed and that the same are true and correct. So help me God.

(Signature) *W. G. Prather*

SUBSCRIBED AND SWORN TO before me this 14th day of January, 1953

(Address)
Salmon Green
Notary Public.

My commission expires Sept. 19, 1956

24-2675-6 2-52-20M

PLUGGING
FILE SEC 1 T 10 R 31
BOOK - PAGE 22 LINE 31

WELL LOG ON OSTMEYER #1

Spudding date: 12-9-52
Date casing set: 12-10-52
Date rotary completed: 1-9-53
Date cable completed:

Location:
Sec. 1-10S-31W - Thomas County, Kansas

FROM	TO	FORMATION	REMARKS
0	235	Surface Hole	Ran 6 Jts. 10-3/4 Casing - 240' Cemented w/ 225 sxs bulk cement, 300# CC.
235	1134	Sand & Shale	
1134	1400	Shale	
1400	1505	Sand & Shale	
1505	1525	Sand	
1525	1700	Shale & Sand	
1700	1875	Shale & Shell	
1875	2300	Sand & Shale	
2300	2430	Shale & Shell	
2430	2595	Shale, Lime Shells	
2595	2815	Shale & Shells	
2815	3065	Shale & Lime Shells	
3065	4130	Lime & Shale	
4130	4265	Lime	
4265	4505	Lime & Shale	
4505	4710	Lime	

Total Depth

Plugging Record

Plug w/ 15 Sxs. Cement & 1/2 sxs. Hull
Drilling Mud to 40'
Plug w/ 10 Sxs. Cement & 1/2 sxs. Hull
to top.

RECEIVED
STATE CORPORATE COMMISSION
JAN 20 1953
CONSERVATION DIVISION
Wichita, Kansas

Subscribed and sworn to before me this 15th
day of January, 19 53

I certify the above and foregoing to be a true and exact
copy of the original driller's log on the OSTMEYER #1.

[Signature]
Notary Public
My commission expires: 8/28/55

HERNDON DRILLING COMPANY
[Signature]
By: [Signature]
Title: Assistant Secretary

PLUGGING
FILE SEC 1 T 10 R 3124
BOOK PAGE 72 LINE 31