

STATE OF KANSAS
STATE CORPORATION COMMISSION

WELL PLUGGING RECORD

Give All Information Completely
Make Required Affidavit
Mail or Deliver Report to
Conservation Division
State Corporation Comm.
245 North Water
Wichita, KS 67202

Thomas County, Sec. 1 Twp. 10S Rge. 31 R/W
Location as "NE/CNW $\frac{1}{4}$ /SW $\frac{1}{4}$ " or footage from lines
C SW NE


Lease Owner Tom Jordan
Lease Name OSTMEYER Well No. 1
Office Address 1700 Broadway, Suite 314, Denver, CO 80202
Character of Well (Completed as Oil, Gas or Dry Hole)
Dry Hole

Date Well completed 1-31-1977
Application for plugging filed (Verbally) 1-31-1977
Application for plugging approved (Verbally) 1-31-1977
Plugging commenced 1-31-1977
Plugging completed 1-31-1977

Reason for abandonment of well or producing formation
No commercial quantity of oil or gas encountered
If a producing well is abandoned, date of last production
19

Was permission obtained from the Conservation Division or
its agents before plugging was commenced? Yes

Name of Conservation Agent who supervised plugging of this well Dwayne Rankin
Producing formation Depth to top Bottom Total Depth of Well
Show depth and thickness of all water, oil and gas formations.

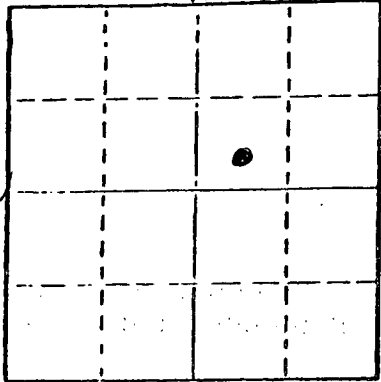

Locate well correctly on above
Section Plot

OIL, GAS OR WATER RECORDS

CASING RECORD

FORMATION	CONTENT	FROM	TO	SIZE	PUT ON	PULLED OUT

Describe in detail the manner in which the well was plugged, indicating where the mud fluid
was placed and the method or methods used in introducing it into the hold. If cement or other
plugs were used, state the character of same and depth placed, from _____ feet to
_____ feet for each plug set.

T.D. 4310'
Set 1st plug at 1400' with 70 sx.
Set 2nd plug at 270' with 20 sx.
Set 3rd plug at 40' with 10 sx.
Rathole with 2 sx.

2-14-77
FEB 14 1977

Plug was down at 5:30 p.m. 1-31-77
State Plugger - Dwayne Rankin

CONSERVATION DIVISION
WICHITA, KANSAS

(If additional description is necessary, use BACK of this sheet)

Name of Plugging Contractor Abercrombie Drilling, Inc.

STATE OF Kansas COUNTY OF Sedgwick ss.
Jack L. Partridge, Asst. Sec.-Treas. (employee of owner) or (owner or operator) of the above-described
well, being first duly sworn on oath, says: That I have knowledge of the facts, statements, and matters herein contained and the log of the
above-described well as filed and that the same are true and correct. So help me God.

(Signature) Jack L. Partridge
801 Union Center, Wichita, Kansas 67202
(Address)

SUBSCRIBED AND SWORN TO before me this 10th day of February 1977

My commission expires _____

Kathy S. Goertz
Kathy S. Goertz Notary Public.



CONTRACTOR'S WELL LOG

OPERATOR: Tom Jordan
 CONTRACTOR: Abercrombie Drilling, Inc.
 WELL NAME: OSTMEYER #1
 LOCATION: C SW NE, Section 1-10S-31W
 Thomas County, Kansas
 SPUD DATE: 1-24-77
 COMPLETION DATE: 1-31-77

0	285	Surface Clay, Shale & Sand
285	2023	Shale & Sand
2023	2390	Sand & Shale
2390	2554	Shale & Shells
2554	2585	Anhydrite
2585	2780	Shale & Lime
2780	2923	Shale
2923	3125	Shale & Shells
3125	3446	Lime & Shale
3446	3501	Shale & Lime
3501	3948	Lime & Shale
3948	4052	Shale & Lime
4052	4181	Lime
4181	4268	Shale & Lime
4268	4310	Lime
	4310	Rotary Total Depth

Spud at 4:30 p.m. 1-24-77. Drilled 285' of 12 1/4" hole. Ran 7 jts. of used 8 5/8" surface casing. (Tally 271.52') Cemented with 200 sx. of common Sunset cement, 2% gel, 3% Ca. Cl. Cement did circulate. Plug was down at 12:00 a.m. 1-25-77.

T.D. 4310'. Set 1st plug at 1400' with 70 sx., 2nd plug at 270' with 20 sx., 3rd plug at 40' with 10 sx., Rathole with 2 sx. Cemented with 200 sx. of common cement, 6% gel. State Plugger - Dwayne Rankin. Job complete at 5:30 p.m. 1-31-77.

SAMPLE TOPS:

Anhydrite 2554' (+428)
 B/Anhydrite 2585' (+397)

STATE OF KANSAS)
) SS
 COUNTY OF SEDGWICK)

Jack L. Partridge, Assistant Secretary-Treasurer of Abercrombie Drilling, Inc., does hereby state that the above and foregoing is a true and correct log of the OSTMEYER #1, C SW NE Section 1-10S-31W, Thomas County, Kansas.

ABERCROMBIE DRILLING, INC.

BY: Jack L. Partridge
 Jack L. Partridge, Asst. Sec.-Treas.

Subscribed and sworn to before me, a Notary Public, in and for the aforesaid county and state as of this 9th day of February, 1977.

Kathy S. Goertz
 Kathy S. Goertz, Notary Public

