


Give All Information Completely
Make Required Affidavit
Mail or Deliver Report to:
Conservation Division
State Corporation Commission
212 No. Market
Wichita, Kansas

WELL PLUGGING RECORD

Trego County, Sec. 3 Twp. 12 Rge. 25 (E) (W) X

Location as "NE/CNW/SW" or footage from lines SW SW NE
Lease Owner Cla-Mar Oil Inc.
Lease Name Lacerte Well No. 1
Office Address 2705 Vine St. Hays, Ks. 67601
Character of Well (completed as Oil, Gas or Dry Hole) Dry Hole
Date well completed 6-2 1983
Application for plugging filed 6-2 1983
Application for plugging approved 6-2 1983
Plugging commenced 6-2 1983
Plugging completed 6-2 1983
Reason for abandonment of well or producing formation Dry Hole

NORTH

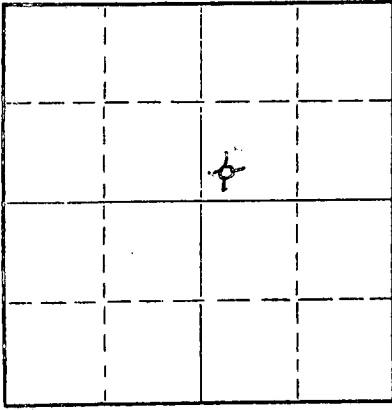

Locate well correctly on above Section Plat

If a producing well is abandoned, date of last production 19
Was permission obtained from the Conservation Division or its agents before plugging was commenced? Yes

Name of Conservation Agent who supervised plugging of this well Marion Schmidt
Producing formation Depth to top Bottom Total Depth of Well 4535' Feet
Show depth and thickness of all water, oil and gas formations.

OIL, GAS OR WATER RECORDS

CASING RECORD

FORMATION	CONTENT	FROM	TO	SIZE	PUT IN	PULLED OUT
Surface		0	227'	8 5/8"	227'	0

Describe in detail the manner in which the well was plugged, indicating where the mud fluid was placed and the method or methods used in introducing it into the hole. If cement or other plugs were used, state the character of same and depth placed, from feet to feet for each plug set.

1st. Plug set at 2280' with 25 sacks common cement 50-50 Poz 6% Gel 3% Cal Cl
2nd. Plug set at 960' with 100 sacks common cement 50-50 Poz 6% Gel 3% Cal Cl
3rd. Plug set at 240 with 40 sacks common cement 50-50 Poz 6 % Gel 3% Cal Cl
4th Plug set at 40' with 10 sacks common cement 50-50 Poz 6% Gel 3% Cal cl
10 sacks in rathole
Heavy drilling mud between each plug.


(If additional description is necessary, use BACK of this sheet)

Name of Plugging Contractor Allied Cementing
Address Russell, Ks.

STATE OF Kansas, COUNTY OF Graham, ss.
Jerry M. Helberg (employee of owner) or (owner or operator) of the above-described well, being first duly sworn on oath, says: That I have knowledge of the facts, statements, and matters herein contained and the log of the above-described well as filed and that the same are true and correct. So help me God.

(Signature) Jerry M. Helberg
Box 32 Morland, Ks. 67650
(Address)

Subscribed and Sworn to before me this 17 day of June, 1983
12-4-83

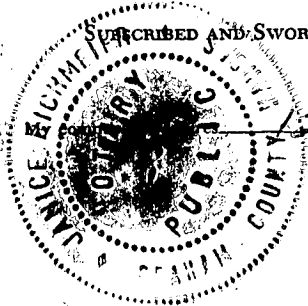

RECEIVED
STATE CORPORATION COMMISSION
Notary Public

JUN 27 1983
06-27-1983
CONSERVATION DIVISION
Wichita, Kansas