


WELL PLUGGING RECORD

Give All Information Completely
Make Required Affidavit
Mail or Deliver Report to:
Conservation Division
State Corporation Commission
800 Bittling Building
Wichita, Kansas

NORTH

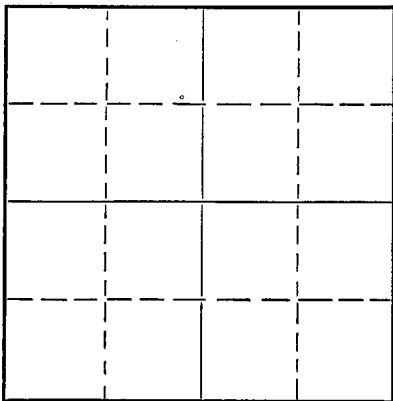

Locate well correctly on above
Section Plat

Trego County. Sec. 26 Twp. 12 Rge. 25 (E) W (W)
Location as "NE/CNW 1/4 SW 1/4" or footage from lines SE SE SW
Lease Owner Victor Drilling, Inc.
Lease Name Lorimer Well No. 1
Office Address 301 Koch Building, Wichita, Kansas
Character of Well (completed as Oil, Gas or Dry Hole) dry hole
Date well completed 4-16-1952
Application for plugging filed 4-16-1952
Application for plugging approved 4-16-1952
Plugging commenced 4-16-1952
Plugging completed 4-16-1952
Reason for abandonment of well or producing formation no commercial shows

If a producing well is abandoned, date of last production 19
Was permission obtained from the Conservation Division or its agents before plugging was commenced? yes

Name of Conservation Agent who supervised plugging of this well Eldon Petty
Producing formation Depth to top Bottom Total Depth of Well 4646 Feet
Show depth and thickness of all water, oil and gas formations.

OIL, GAS OR WATER RECORDS

CASING RECORD

Formation	Content	From	To	Size	Put In	Pulled Out
				8 5/8	264'	none

Describe in detail the manner in which the well was plugged, indicating where the mud fluid was placed and the method or methods used in introducing it into the hole. If cement or other plugs were used, state the character of same and depth placed, from feet to feet for each plug set.
Filled with heavy rotary mud from 4646, total depth to 240'
Rock bridge and cement with 15 sx cement. Top plug to 45' with 10 sx cement.

RECEIVED
STATE CORPORATION COMMISSION
APR 24 1952
CONC 04-2408
04-24-52


(If additional description is necessary, use BACK of this sheet)

Name of Plugging Contractor Victor Drilling, Inc.
Address 301 Koch Building
Wichita 2, Kansas

STATE OF Kansas, COUNTY OF Sedgwick, ss.
Victor F. Reiserer (employee of owner) or (owner or operator) of the above-described well,
being first duly sworn on oath, says: That I have knowledge of the facts, statements, and matters herein contained and the log of the above-described well as filed and that the same are true and correct. So help me God.

(Signature) Victor F. Reiserer
301 Koch Building, Wichita, Kansas (Address)

SUBSCRIBED AND SWORN to before me this 21st day of April, 1952.
Notary Public.

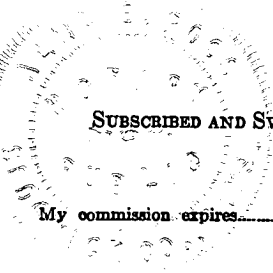

My commission expires July 16, 1955
23-8390-s 6-51-20M
PLUGGING
FILE SEC 26 Twp 12 R 25 W
BOOK PAGE 9 LINE 24

Victor Drilling, Inc.
#1 Lorimer

SE SE SW
26-12S-25W
Trego County

Spud: 3-28-52
Comp: 4-16-52

Elev. 2478 KB

8 5/8" @ 264' 125 sx

sand & shells	0-70
sand, shells & sand	264
shale & sand	1715
red bed & shale	2030
Anhydrite	2060
lime & shale	2285
shale & lime	2440
shale & shells	2640
shale & lime	2750
shale & lime	2880
lime	2955
shale & lime	3115
lime & shale	3235
shale & lime	3310
lime & shale	3368
lime	3537
shale & lime	3586
shale & lime	3686
lime & shale	3736
shale & lime	3780
lime	3845
lime	3922
lime	3964
lime	3978
lime	4105
lime & shale	4150
shale & lime	4170
shale	4177
shale	4230
shale & lime	4278
lime & shale	4328
lime & shale	4345
shale & lime	4395
lime	4416
chert & lime	4444
lime & chert	4481
lime	4513
cherty lime	4539
lime & chert	4563
lime & chert	4582
lime & chert	4617
lime	4640
Total Depth	4640
(Schlumberger)	4646

FORMATION TOPS:

Heebner	3799
Toronto	3812
Lansing	3838
Marmaton	4101
Mississippian ?	4314
xln. Viola	4562
Arbuckle	4604

OH-24-1952

State of Kansas)
) ss:
County of Sedgwick)

I hereby certify the foregoing is true and correct to the best of my knowledge.

Victor F. Reiserer
Victor F. Reiserer

Subscribed and sworn to before me, a Notary Public, this 21st day of April, 1952.

Alvin E. Reiserer
Notary Public

My commission expires July 16, 1955.

PLUGGING
FILE SEC 26 12 R 25W
BOOK PAGE 9 2W