


STATE OF KANSAS  
STATE CORPORATION COMMISSION

Give All Information Completely  
Make Required Affidavit  
Mail or Deliver Report to:  
Conservation Division  
State Corporation Commission  
212 North Market, Insurance Bldg.  
Wichita, Kansas

WELL PLUGGING RECORD

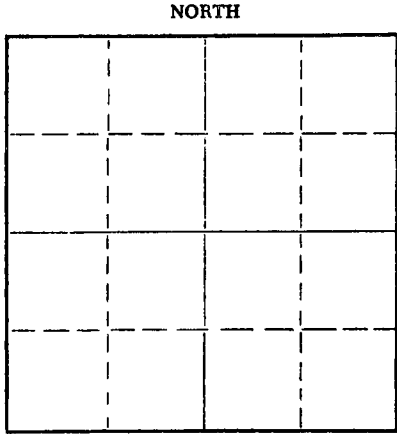

Locate well correctly on above  
Section Plat

Gove County. Sec. 4 Twp. 12S Rge. 26W (E) (W)  
Location as "NE/CNW/SW" or footage from lines SW SW SE  
Lease Owner Herndon Drilling Co.  
Lease Name Boone Well No. 1  
Office Address P.O. Box 499, Tulsa, Oklahoma 74101  
Character of Well (completed as Oil, Gas or Dry Hole) Dryhole  
Date well completed 11-29-71 19  
Application for plugging filed 11-29-71 19  
Application for plugging approved 11-29-71 19  
Plugging commenced 11-29-71 19  
Plugging completed 11-29-71 5:15 p.m. 19  
Reason for abandonment of well or producing formation \_\_\_\_\_

If a producing well is abandoned, date of last production \_\_\_\_\_ 19  
Was permission obtained from the Conservation Division or its agents before plugging was commenced? yes

Name of Conservation Agent who supervised plugging of this well W. L. Nichols  
Producing formation \_\_\_\_\_ Depth to top \_\_\_\_\_ Bottom \_\_\_\_\_ Total Depth of Well \_\_\_\_\_ Feet  
Show depth and thickness of all water, oil and gas formations.

OIL, GAS OR WATER RECORDS


CASING RECORD

FORMATION	CONTENT	FROM	TO	SIZE	PUT IN	PULLED OUT

Describe in detail the manner in which the well was plugged, indicating where the mud fluid was placed and the method or methods used in introducing it into the hole. If cement or other plugs were used, state the character of same and depth placed, from \_\_\_\_\_ feet to \_\_\_\_\_ feet for each plug set.

Plug #1 1100' 115 sx cement  
#2 215' 30 sx cement  
#3 40' 10 sx cement

W. L. Nichols State Plugger  
Morland, Kansas

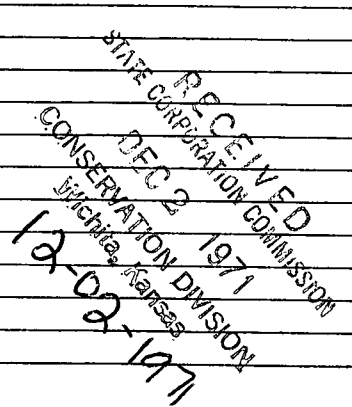


(If additional description is necessary, use BACK of this sheet)

Name of Plugging Contractor John O. Farmer, Inc.  
Address Russell, Kansas

STATE OF Kansas, COUNTY OF Russell, ss.  
\_\_\_\_\_  
(employee of owner) or (owner or operator) of the above-described well, being first duly sworn on oath, says: That I have knowledge of the facts, statements, and matters herein contained and the log of the above-described well and that the same are true and correct. So help me God.

(Signature) John O. Farmer  
Box 352, Russell, Kansas 67665  
(Address)

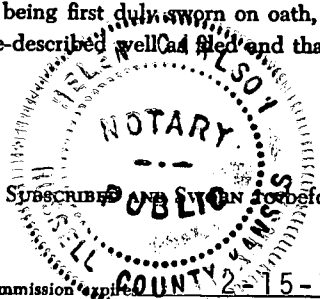

Subscribed and sworn to before me this 1st day of December, 1971  
\_\_\_\_\_  
Helen Carlson  
Notary Public.

OPERATOR Herndon Drilling Company


15-063-20094-00-26W

FORMATION RECORD

ADDRESS Tulsa, Oklahoma

Give detailed description and thickness of all formation drilled through, contents of sand, whether dry, water, oil or gas.

340 Acres  
N

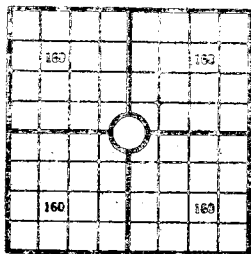

Locate well correctly

COUNTY Gove SEC. 4 TWP. 12S RGE. 26W  
 COMPANY OPERATING John O. Farmer, Inc.  
 OFFICE ADDRESS Russell, Kansas  
 DRILLING STARTED 11-23-71 DRILLING FINISHED 11-29-71  
 DATE OF FIRST PRODUCTION \_\_\_\_\_ COMPLETED \_\_\_\_\_  
 WELL LOCATED SW 1/4 SW 1/4 SE 1/4, North of South  
 Line end \_\_\_\_\_ ft. East of West Line of Quarter Section.  
 Elevation (Relative to sea level) DERRICK FLOOR 260.1 GROUND, 2596  
 CHARACTER OF WELL (Oil, gas or dryhole) Dryhole

Formation	Top	Bottom	Formation	Top	Bottom
Anhydrite	2207				
Heebner	3892				
Toronto	3918				
Lansing	3932				
B/Kansas City	4191				
T.D.	4200				

OIL OR GAS SANDS OR ZONES

Name	From	To	Name	From	To
1			4		
2			5		
3			6		

Perforating Record If Any

Shot Record

Formation	From	To	No. of Shots	Formation	From	To	Size of Shot

CASING RECORD

Amount Set								Amount Pulled		Packer Record	
Size	Wt.	Thds.	Make	Ft.	In.	Ft.	In.	Size	Length	Depth Set	Make

Liner Record: Amount \_\_\_\_\_ Kind \_\_\_\_\_ Top \_\_\_\_\_ Bottom \_\_\_\_\_

CEMENTING AND MUDDING

Size	Amount Set		Sacks Cement	Chemical		Method of Cementing	Amount	Mudding Method	Results (See Note)
	Ft.	In.		Gal.	Make				
8-5/8	208		175						

Note: What method was used to protect sands if outer strings were pulled?

NOTE: Were bottom hole plugs used? \_\_\_\_\_ If so, state kind, depth set and results obtained \_\_\_\_\_

TOOLS USED

Rotary Tools were used from 0 feet to 4200 Cable tools were used from \_\_\_\_\_ feet to \_\_\_\_\_ feet, and from \_\_\_\_\_ feet to \_\_\_\_\_ feet, and from \_\_\_\_\_ feet to \_\_\_\_\_ feet to \_\_\_\_\_

Type Rig Rotary

INITIAL PRODUCTION TEST

Describe initial test: whether by flow through tubing or casing or by pumping \_\_\_\_\_


Amount of Oil Production \_\_\_\_\_ bbls. Size of choke, if any \_\_\_\_\_ Length of test \_\_\_\_\_ Water

Production \_\_\_\_\_ bbls. Gravity of oil \_\_\_\_\_ Type of Pump if pump is used, describe \_\_\_\_\_

SAMPLE TOPS

Shale	208	888
Shale & Sand	888	1590
Shale	1590	1740
Sand	1740	1880
Red Bed	1880	2207
Anhydrite	2207	2267
Shale & Shells	2267	2445
Shale & Lime	2445	2900
Lime & Shale	2900	3930
Lime	3930	4200
R.T.D.	4200	

RECEIVED  
 STATE DEPARTMENT OF CONSERVATION  
 DEC 2 1971  
 CONSERVATION DIVISION  
 Wichita, Kansas  
 12-02-1971

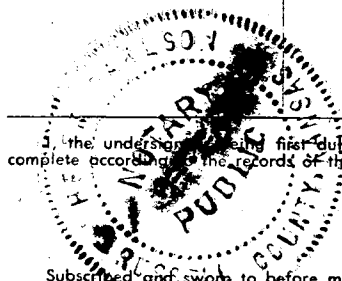

I, the undersigned, being the first duty sworn upon oath, state that this well record is true, correct and complete according to the records of this office and to the best of my knowledge and belief.

John O. Farmer  
 Name and title of representative of company

Subscribed and sworn to before me this 1st day of December, 1971

My Commission expires 2-15-75

Helen Carlson  
 Notary Public.

FARM NAME BOONE WELL NO. 1 COUNTY G.O.V.C. SEC. 4 TWP. 12S RGE. 26W