

15-063-00107-00-00


STATE OF KANSAS
STATE CORPORATION COMMISSION

Form CP-4

Give All Information Completely
Make Required Affidavit
Mail or Deliver Report to:
Conservation Division
State Corporation Commission
211 No. Broadway
Wichita, Kansas

WELL PLUGGING RECORD

NORTH

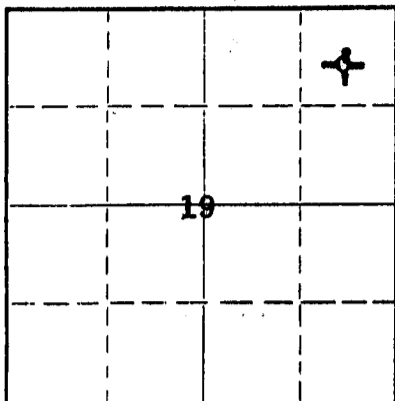

Locate well correctly on above
Section Plat

Gove County, Sec. 19 Twp. 12S Rge. 26W (XX) (W)

Location as "NE/CNW/SW" or footage from lines C NE NE
Lease Owner D. R. Lauck Oil Company, Inc.
Lease Name Graham Well No. 1
Office Address 301 South Broadway, Wichita, Kansas
Character of Well (completed as Oil, Gas or Dry Hole) Dry Hole
Date well completed October 16, 1964
Application for plugging filed October 16, 1964
Application for plugging approved October 16, 1964
Plugging commenced October 16, 1964
Plugging completed October 16, 1964
Reason for abandonment of well or producing formation Dry Hole

If a producing well is abandoned, date of last production _____ 19____
Was permission obtained from the Conservation Division or its agents before plugging was commenced? Yes

Name of Conservation Agent who supervised plugging of this well Bill Nichols
Producing formation _____ Depth to top _____ Bottom _____ Total Depth of Well 4660 Feet
Show depth and thickness of all water, oil and gas formations.

OIL, GAS OR WATER RECORDS

CASING RECORD

FORMATION	CONTENT	FRDM	TO	SIZE	PUT IN	PULLED OUT
		0'	206'	8-5/8"	206'	None

Describe in detail the manner in which the well was plugged, indicating where the mud fluid was placed and the method or methods used in introducing it into the hole. If cement or other plugs were used, state the character of same and depth placed, from _____ feet to _____ feet for each plug set.

4660'-540'	Mud
540'-536'	Plug
536'-496'	Cement, 20 sacks
496'-190'	Mud
190'-186'	Plug
186'-146'	Cement, 20 sacks
146'-40'	Mud
40'-36'	Plug
36'-6'	Cement, 10 sacks (Bottom of cellar)

RECEIVED
STATE CORPORATION COMMISSION
OCT 28 1964
10-28-1964
CONSERVATION DIVISION
Wichita, Kansas

(If additional description is necessary, use BACK of this sheet)

Name of Plugging Contractor Halliburton Oil Well Cementing Co.
Address Great Bend, Kansas

STATE OF KANSAS, COUNTY OF SEDGWICK, ss.
John H. Knightley (employee of owner) or ~~owner or operator~~ of the above-described

well, being first duly sworn on oath, says: That I have knowledge of the facts, statements, and matters herein contained and the log of the above-described well as filed and that the same are true and correct. So help me God.

(Signature) John H. Knightley
301 South Broadway, Wichita, Kansas
(Address)

SUBSCRIBED AND SWORN TO before me this 27th day of October, 1964

My commission expires March 12, 1967 Stella J. Lipp Notary Public.

15-063-00107-00-00

D. R. Lauck Oil Company, Inc.

Graham #1

C NE NE Sec. 19-12S-26W
Gove County, Kansas

Commenced: October 4, 1964
Completed: October 16, 1964

Casing Record: 206' 8-5/8" Cemented with 160 sacks Cement,
3 sacks Calcium Chloride.

Elevation: 2667 GL; 2670 DF; 2672 KB.

Drillers Log

Tops

Clay	30
Sand	56
Clay & Shale	206
Shale	940
Sand	1095
Shale	1300
Shale & Shells	1750
Salt	1850
Red Bed, Shale & Shells	2030
Anhydrite	2040
Shale & Shells	2260
Lime & Shale	2795
Shale & Lime	2860
Lime & Shale	2935
Lime	3200
Lime & Shale	3305
Lime	4440
Shale & Lime	4530
Lime	4555
Chert & Sand	4564
Lime & Shale	4590
Lime & Chert	4641
Chert & Lime Streaks	4660 RTD

Sample#	Welex
Anhydrite	2250 +422
Heebner	3947-1275 3948-1276
Toronto	3969-1297 3972-1300
Lansing	3985-1313 3988-1316
Base Kansas City	4259-1587 4256-1584
Cherokee	4466-1794 4470-1798
Mississippian	4586-1914 4587-1915
Total Depth	4660-1988 4640-1968

*All sample tops were corrected after the electrical log was run, with the exception of the Mississippian. The electric logging tools all encountered a bridge at 4640.

DST #1 (H) 4589-4660, open 1 hour with strong blow. Recovered 3200' salt water.
ISIP 1329#/30 min.
FSIP 1329#/30 min.
IFP 269#
FFP 1275#

I hereby certify that this is a true and correct log of the above mentioned well, to the best of my knowledge and belief.

John H. Knapp
Subscribed and sworn to before me this

27th day of October 1964

Stella J. Lipp
Notary Public

My commission expires 3-12-67

D&A

RECEIVED
STATE CORPORATION COMMISSION
OCT 28 1964
10-28-1964
CONSERVATION DIVISION
Wichita, Kansas