


STATE OF KANSAS
STATE CORPORATION COMMISSION

WELL PLUGGING RECORD

Give All Information Completely
Make Required Affidavit
Mail or Deliver Report to:
Conservation Division
State Corporation Commission
311 No. Broadway
Wichita, Kansas

Gove County, Sec. 34 Twp. 12S Rge. 26W (XX) (W)
Location as "NE/CNW/SE/SW" or footage from lines C NE SW
Lease Owner D. R. Lauck Oil Company, Inc.
Lease Name Ziegler Well No. 1
Office Address 301 S. Broadway, Wichita, Kansas
Character of Well (completed as Oil, Gas or Dry Hole) Dry Hole
Date well completed November 13, 19 64
Application for plugging filed November 13, 19 64
Application for plugging approved November 13, 19 64
Plugging commenced November 13, 19 64
Plugging completed November 13, 19 64
Reason for abandonment of well or producing formation Dry Hole

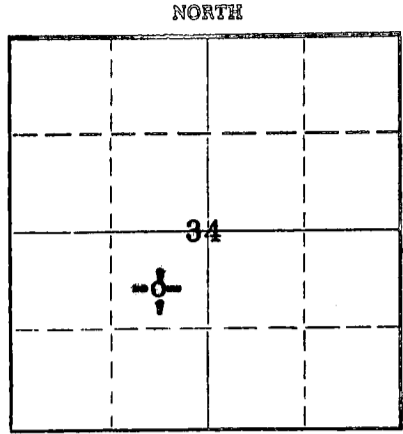

Locate well correctly on above
Section Plat

If a producing well is abandoned, date of last production _____ 19____
Was permission obtained from the Conservation Division or its agents before plugging was commenced? Yes

Name of Conservation Agent who supervised plugging of this well Bill Nichols
Producing formation _____ Depth to top _____ Bottom _____ Total Depth of Well 4543 Feet
Show depth and thickness of all water, oil and gas formations.

OIL, GAS OR WATER RECORDS				CASING RECORD		
FORMATION	CONTENT	FROM	TO	SIZE	PUT IN	PULLED OUT
		0'	216'	8-5/8"	216'	None

Describe in detail the manner in which the well was plugged, indicating where the mud fluid was placed and the method or methods used in introducing it into the hole. If cement or other plugs were used, state the character of same and depth placed, from _____ feet to _____ feet for each plug set.

- 4543'-540' Mud
- 540'-536' Plug
- 536'-496' Cement, 20 sacks
- 496'-210' Mud
- 210'-206' Plug
- 206'-166' Cement, 20 sacks
- 166'- 40' Mud
- 40'- 36' Plug
- 36'- 6' Cement, 10 sacks (Bottom of Cellar)


RECEIVED
STATE CORPORATION COMMISSION
DEC 9 1964
12-09-1964
CONSERVATION DIVISION
Wichita, Kansas

(If additional description is necessary, use BACK of this sheet)
Name of Plugging Contractor Sun Cementing Co.
Address Great Bend, Kansas

STATE OF KANSAS, COUNTY OF SEDGWICK, ss.
John H. Knightley (employee of owner) or (owner or operator) of the above-described well, being first duly sworn on oath, says: That I have knowledge of the facts, statements, and matters herein contained and the log of the above-described well as filed and that the same are true and correct. So help me God.

(Signature) John H. Knightley
301 S. Broadway, Wichita, Kansas
(Address)

SUBSCRIBED AND SWORN to before me this 4th day of December, 19 64
Stella J. Lypa Notary Public.
My commission expires March 12, 1967

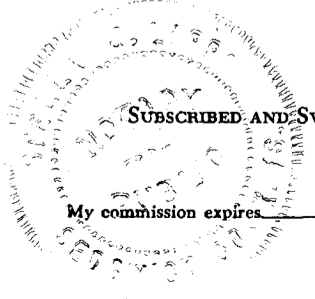

15-063-00108-00-00

D. R. Lauck Oil Company, Inc.

Ziegler #1

C NE SW Sec. 34-12S-26W
Gove County, Kansas

RECEIVED
STATE CORPORATION COMMISSION

DEC 9 1964
12-09-1964

CONSERVATION DIVISION
Wichita, Kansas

Commenced: October 31, 1964
Completed: November 13, 1964

Casing Record: 216' 8-5/8" Cemented with 160 sacks Cement,
3 sacks Calcium Chloride.

Elevation: 2580 GL; 2583 DF; 2585 KB.

Drillers Log

Tops

Surface Clay & Sand	75
Shale	810
Sand & Sandy Shale	940
Shale	1009
Sand	1020
Shale & Shells	1600
Shale & Shells w/Sand	1920
Red Bed	2110
Anhydrite	2151
Shale & Shells	2525
Shale w/Lime Streaks	2690
Lime & Shale	3100
Lime	3310
Lime & Shale	3410
Lime, Broken	3510
Lime	3605
Lime & Shale	3683
Lime	3820
Lime & Shale	3869
Lime	3920
Lime & Shale	3980
Lime	4250
Lime & Shale	4353
Lime	4395
Lime & Shale	4440
Lime	4485
Cherty Lime, Dolomite and Shale	4535
Chert	4543 RTD

	Sample	Welex
Anhydrite	2110 +475	
Heebner	3815-1230	3816-1231
Toronto	3838-1253	3840-1255
Lansing	3854-1269	3854-1269
Base Kansas City	4125-1540	4126-1541
Pawnee	4245-1660	4236-1651
Ft. Scott	4274-1689	4276-1691
Cherokee	4333-1748	4336-1751
Mississippian	4449-1864	4444-1859
Total Depth	4543-1958	4543-1958

DST #1 (W) 3882-3920, open 1 hour with strong blow. Recovered 2200' muddy salt water.
 ISIP 1312#/30 min.
 FSIP 1291#/30 min.
 IFP 151#
 FFP 378#

DST #2 (W) 4451-4465, open 1 hour with weak blow 5 min, flushed, no help. Recovered 10' mud.
 ISIP 1216#/30 min.
 FSIP 722#/30 min.
 IFP 21#
 FFP 21#

DST #3 (W) 4465-4543, open 1 hour with strong blow thruout. Recovered 1500' muddy salt water.
 ISIP 1302#/30 min.
 FSIP 1291#/30 min.
 IFP 97#
 FFP 744#

D&A

I hereby certify that this is a true and correct log of the above mentioned well, to the best of my knowledge and belief.

Subscribed and sworn to before me this 4th day of December 1964

Stella J. Lips
Notary Public

My commission expires 3-12-67