

CARD MUST BE TYPED

State of Kansas NOTICE OF INTENTION TO DRILL

(see rules on reverse side)

CARD MUST BE SIGNED

Starting Date: 11-³⁰23-84
month day year

API Number 15- 063-20,856-00-00

OPERATOR: License # 9903
Name IREX Operating Company
Address 1331-17th St., Suite 800
City/State/Zip Denver, Colorado 80202
Contact Person WILLIAM H. BAYLIFF
Phone 303/292-9900

SENECA Sec. 15 Twp. 12 S, Rge. 28.
(location) East West

3465' Ft North from Southeast Corner of Section
990' Ft West from Southeast Corner of Section
(Note: Locate well on Section Plat on reverse side)

CONTRACTOR: License # 5422
Name Abercrombe Drilling, Inc.
City/State Wichita, KS 67202

Nearest lease or unit boundary line 990 feet.
County Gove
Lease Name GOVE Well# 15-1

Well Drilled For: Well Class: Type Equipment:
 Oil Swd Infield Mud Rotary
 Gas Inj Pool Ext. Air Rotary
 OWWO Expl Wildcat Cable

Domestic well within 330 feet: yes no
Municipal well within one mile: yes no

If OWWO: old well info as follows:

Operator
Well Name
Comp Date Old Total Depth
Projected Total Depth 4400 feet
Projected Formation at TD Mississippian
Expected Producing Formations Cherokee/Mississippian

Depth to Bottom of fresh water 250 feet
Lowest usable water formation DAKOTA
Depth to Bottom of usable water 1225 feet
Surface pipe by Alternate: 1 2
Surface pipe to be set 1225 feet
Conductor pipe if any required 60 feet
Ground surface elevation 2700 est. feet MSL
This Authorization Expires 5-26-85
Approved By 11-26-84 [Signature]

I certify that we will comply with K.S.A. 55-101, et seq., plus eventually plugging hole to K.C.C. specifications.

Date 11/21/84 Signature of Operator or Agent


William H. Bayliff

MHC/KOHE 11/26/84
Operations Manager

Must be filed with the K.C.C. five (5) days prior to commencing well
This card void if drilling not started within six (6) months of date received by K.C.C.

Important procedures to follow :

**A Regular Section of Land
1 Mile = 5,280 Ft.**

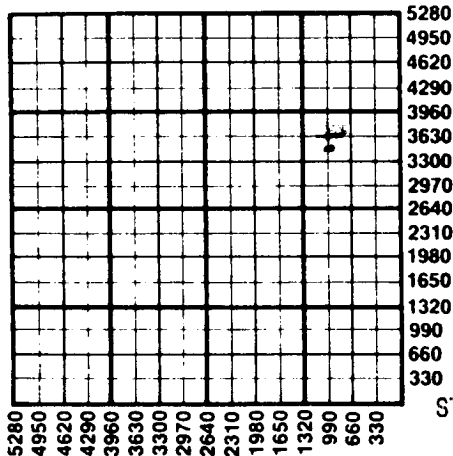

1. Notify District office before setting surface casing.
2. Set surface casing by circulating cement to the top.
3. File completion forms ACO-1 with K.C.C. within 90 days of well completion, following instructions on ACO-1, side 1, and including copies of wireline logs.
4. Notify District office 48 hours prior to old well workover or re-entry.
5. Prior to plugging, prepare a plugging plan, then obtain agreement from the appropriate district office for an approved plugging plan.
6. Submit plugging report (CP-4) to K.C.C. after plugging is completed.
7. Obtain an approved injection docket number before disposing of salt water.
8. Notify K.C.C. within 10 days when injection commences or terminates.
9. If an alternate 2 completion, cement in the production pipe from below any usable water to surface within 120 days of spud date.

RECEIVED
STATE CORPORATION COMMISSION

NOV 26 1984
11-26-1984
CONSERVATION DIVISION
Wichita, Kansas

State Corporation Commission of Kansas
Conservation Division
200 Colorado Derby Building
Wichita, Kansas 67202
(316) 263-3238