

NOTICE OF INTENTION TO DRILL

(see rules on reverse side)

Starting Date OCTOBER 13 1986 month day year

API Number 15-063-21,063-00-00

OPERATOR: License # 5923 Name AMERICAN PETROLEUM COMPANY, INC. Address 400 N. WOODLAWN, SUITE 111 City/State/Zip WICHITA, KANSAS 67208 Contact Person JAMES T. BARVAIS Phone (316) 684-5273

SE SW NW Sec. 9 Twp. 12 S, Rg. 30 East X West 2970 Ft. from South Line of Section 4290 Ft. from East Line of Section

(Note: Locate well on Section Plat on reverse side)

CONTRACTOR: License # 5929 Name DUKE DRILLING CO., INC. City/State GREAT BEND, KANSAS 67530

Nearest lease or unit boundary line 660 feet County GOVE

Well Drilled For: Well Class: Type Equipment: X Oil SWD Infield X Mud Rotary Gas Inj Pool Ext Air Rotary OWWO Expl X Wildcat Cable

Lease Name OTTLEY Well # 1

Ground surface elevation 2795 feet MSL

Domestic well within 330 feet: yes X no

Municipal well within one mile: yes X no

Depth to bottom of fresh water 50

Depth to bottom of usable water 800/1400

Surface pipe by Alternate: 1 2 XX

Surface pipe planned to be set 250'

Conductor pipe required NONE

Projected Total Depth 4600 feet

Formation MISSISSIPPIAN

If OWWO: old well info as follows:

Operator Well Name Comp Date Old Total Depth

I certify that well will comply with K.S.A. 55-101, et seq., plus eventually plugging hole to KCC specifications.

Date 9-25-86 Signature of Operator or Agent JAMES T. BARVAIS Title PRESIDENT

For KCC Use:

Conductor Pipe Required feet; Minimum Surface Pipe Required 200 feet per Alt. #2

This Authorization Expires 3-26-87 Approved By 9-26-86


Handwritten signature and initials: RCH/KCC

Must be filed with the K.C.C. five (5) days prior to commencing well
This card void if drilling not started within six (6) months of date received by K.C.C.

Important procedures to follow:

1. Notify District office before setting surface casing.
2. Set surface casing by circulating cement to the top.
3. File completion forms ACO-1 with K.C.C. within 90 days of well completion, following instructions on ACO-1, side 1, and including copies of wireline logs.
4. Notify District office 48 hours prior to old well workover or re-entry.
5. Prior to filing Intent, prepare a proposed plugging plan in case well is D & A, then obtain approval of plan when calling district office prior to setting surface pipe.
6. Submit plugging report (CP-4) to K.C.C. after plugging is completed.
7. Obtain an approved injection docket number before disposing of salt water.
8. Notify K.C.C. within 10 days when injection commences or terminates.
9. If an alternate 2 completion, cement in the production pipe from below any usable water to surface within 120 days of spud date.

A Regular Section of Land 1 Mile = 5,280 Ft.

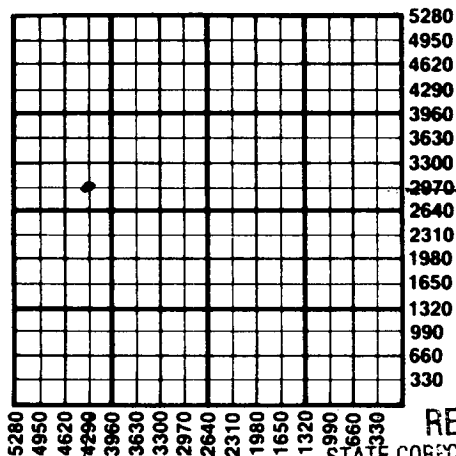

RECEIVED

SEP 26 1980
09-26-1980
CONSERVATION DIVISION
Wichita, Kansas

State Corporation Commission of Kansas
Conservation Division
200 Colorado Derby Building
Wichita, Kansas 67202
(316) 263-3238