

NOTICE OF INTENTION TO DRILL

(see rules on reverse side)

Starting Date 6/25/86 month day year 3:11

API Number 15- 129-20,818-0000

OPERATOR: License # 5181 Name Donald C. Slawson Address Suite 700, 20 N. Broadway City/State/Zip Oklahoma City, OK 73102 Contact Person Daniel G. Wilson Phone (405) 232-0201

NW. SW. NW. Sec. 34... Twp. 31... S, Rg. 40... X West 3630 Ft. from South Line of Section 4950 Ft. from East Line of Section

(Note: Locate well on Section Plat on reverse side)

CONTRACTOR: License # 5657 Name Slawson Drilling Company City/State Great Bend, KS

Nearest lease or unit boundary line 330 feet County Morton Lease Name Breeding Well # 1-34

Ground surface elevation 3390 est feet MSL

Well Drilled For: Well Class: Type Equipment: X Oil SWD Infield X Mud Rotary X Gas Inj Pool Ext Air Rotary OWWO Expl X Wildcat Cable

Domestic well within 330 feet: yes X no Municipal well within one mile: yes X no

If OWWO: old well info as follows:

Depth to bottom of fresh water 280 Depth to bottom of usable water 500 Surface pipe by Alternate 1 X 2 Surface pipe planned to be set 1,570 Conductor pipe required 77 Projected Total Depth 6,000 feet Formation Upper Morrow

Operator Well Name Comp Date Old Total Depth

I certify that well will comply with K.S.A. 55-101, et seq., plus eventually plugging hole to KCC specifications.

Date 6/24/86 Signature of Operator or Agent James C. Remsberg Title Manager of Operations

For KCC Use:


Conductor Pipe Required feet; Minimum Surface Pipe Required 500 feet per Alt. 1 of This Authorization Expires 12-24-86 Approved By 6-24-86 RCH/1108E

Must be filed with the K.C.C. five (5) days prior to commencing well
 This card void if drilling not started within six (6) months of date received by K.C.C.

Important procedures to follow:

1. Notify District office before setting surface casing.
2. Set surface casing by circulating cement to the top.
3. File completion forms ACO-1 with K.C.C. within 90 days of well completion, following instructions on ACO-1, side 1, and including copies of wireline logs.
4. Notify District office 48 hours prior to old well workover or re-entry.
5. Prior to filing Intent, prepare a proposed plugging plan in case well is D & A, then obtain approval of plan when calling district office prior to setting surface pipe.
6. Submit plugging report (CP-4) to K.C.C. after plugging is completed.
7. Obtain an approved injection docket number before disposing of salt water.
8. Notify K.C.C. within 10 days when injection commences or terminates.

**A Regular Section of Land
 1 Mile = 5,280 Ft.**

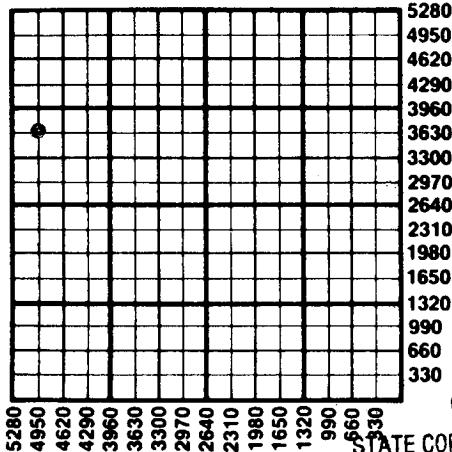

RECEIVED

STATE CORPORATION COMMISSION

JUN 24 1986
 6-24-86
 CONSERVATION DIVISION
 Wichita, Kansas

alternate 2 completion, cement in the production pipe from below any usable water to surface within 120 days of spud date.

State Corporation Commission of Kansas
 Conservation Division
 200 Colorado Derby Building
 Wichita, Kansas 67202
 (316) 263-3238