

15-063-00117-00-00


STATE OF KANSAS  
STATE CORPORATION COMMISSION

Form CP-4

Give All Information Completely  
Make Required Affidavit  
Mail or Deliver Report to:  
Conservation Division  
State Corporation Commission  
211 No. Broadway  
Wichita, Kansas

WELL PLUGGING RECORD

NORTH

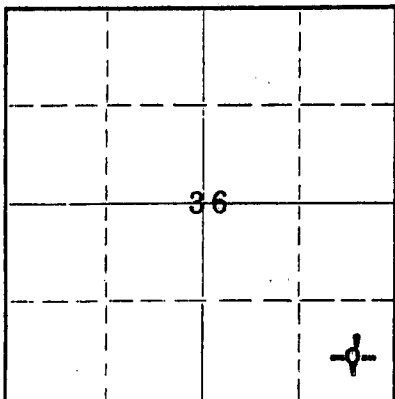

Locate well correctly on above  
Section Plat

Gove County, Sec. 36 Twp. 12S Rge. 28W (EX) (W)

Location as "NE/CNW%SW%" or footage from lines C SE SE  
Lease Owner D. R. Lauck Oil Company, Inc.  
Lease Name Martin Well No. 1  
Office Address 301 S. Broadway, Wichita, Kansas  
Character of Well (completed as Oil, Gas or Dry Hole) Dry Hole  
Date well completed October 4, 19 64  
Application for plugging filed October 4, 19 64  
Application for plugging approved October 4, 19 64  
Plugging commenced October 4, 19 64  
Plugging completed October 4, 19 64  
Reason for abandonment of well or producing formation Dry Hole

If a producing well is abandoned, date of last production \_\_\_\_\_ 19\_\_\_\_  
Was permission obtained from the Conservation Division or its agents before plugging was commenced? Yes

Name of Conservation Agent who supervised plugging of this well Bill Nichols  
Producing formation \_\_\_\_\_ Depth to top \_\_\_\_\_ Bottom \_\_\_\_\_ Total Depth of Well 4440' Feet  
Show depth and thickness of all water, oil and gas formations.

OIL, GAS OR WATER RECORDS

CASING RECORD

FORMATION	CONTENT	FROM	TO	SIZE	PUT IN	PULLED OUT
		0'	200'	8-5/8"	200'	None

Describe in detail the manner in which the well was plugged, indicating where the mud fluid was placed and the method or methods used in introducing it into the hole. If cement or other plugs were used, state the character of same and depth placed, from \_\_\_\_\_ feet to \_\_\_\_\_ feet for each plug set.

4440'-540' Mud  
540'-536' Plug  
536'-496' Cement, 25 sacks  
496'-190' Mud  
190'-186' Plug  
186'-146' Cement, 25 sacks  
146'- 40' Mud  
40'- 36' Plug  
36'- 6' Cement, 10 sacks (Bottom of Cellar)

RECEIVED  
STATE CORPORATION COMMISSION

OCT 12 1964  
10-12-1964  
CONSERVATION DIVISION  
Wichita, Kansas

(If additional description is necessary, use BACK of this sheet)

Name of Plugging Contractor Sun Cementing Co.  
Address Great Bend, Kansas

STATE OF KANSAS, COUNTY OF SEDGWICK, ss.

John H. Knightley (employee of owner) or (owner or operator) of the above-described well, being first duly sworn on oath, says: That I have knowledge of the facts, statements, and matters herein contained and the log of the above-described well as filed and that the same are true and correct. So help me God.

(Signature) John H. Knightley  
301 S. Broadway, Wichita, Kansas (Address)

SUBSCRIBED AND SWORN to before me this 9th day of October, 19 64

My commission expires March 12, 1967

Stella J. Lipp Notary Public.

15-063-00117-00-00

D. R. Lauck Oil Company, Inc.

Martin #1

C SE SE Sec. 36-12S-28W  
Gove County, Kansas

Commenced: September 21, 1964

Completed: October 4, 1964

Casing Record: 200' 8-5/8" Cemented with 160 sacks Cement,  
3 sacks Calcium Chloride.

Elevation: 2576 GL; 2579 DF; 2581 KB.

Drillers Log

Tops

Clay & Shale	200
Shale	825
Sand	950
Shale	1200
Shale & Shells	2050
Anhydrite	2099
Shale	2223
Shale & Shells	2445
Shale & Shells	2524
Lime & Shale	2660
Lime	3350
Lime & Shale	3480
Shale & Lime	3545
Lime & Shale	3640
Lime	3708
Lime, cherty	3795
Lime	4180
Shale & Lime	4285
Lime & Shale	4342
Chert	4367
Dolomite	4403
Dolomite & Lime	4440 RTD

	Sample	Welex
Heebner	3718-1137	3718-1137
Toronto	3740-1159	3740-1159
Lansing-KC	3759-1178	3759-1178
Base Kansas City	4042-1461	4041-1460
Cherokee Shale	4243-1662	4241-1660
Mississippian	4334-1753	4334-1753
Total Depth	4440-1859	4441-1860


DST #1 (S) 3835-45, straddle packers, 52' of tail pipe. Open 37 minutes w/ weak blow 6 minutes, flushed tool, no help. Recovered 10' drilling mud. ISIP 1247#/30 min. FSIP 1126#/20 min. IFP 14#. FFP 22#.

DST #2 (S) 4336-45, open 20 minutes, w/ weak blow 7 minutes, flushed tool, lost packer seat. Recovered 480' drilling mud. ISIP 977#/30 min. IFP 83#. FFP 83#.

DST #3 (S) 4357-67, open 1 hr. w/weak blow 17 minutes. Recovered 90' slightly oil cut mud, possibly one cup of free oil in tool. ISIP 1239#/30 min. FSIP 560#/30 min. IFP 58#. FFP 83#.

DST #4, 4367-77, packers failed.

D&A

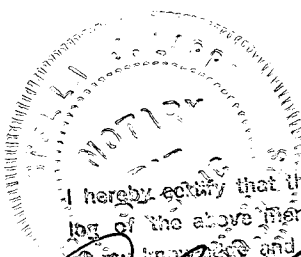

I hereby certify that this is a true and correct log of the above mentioned well, to the best of my knowledge and belief.

*John B. Krueffley*  
Subscribed and sworn to before me this

9<sup>th</sup> day of October 1964

*Stella J. Lippa*  
Notary Public

My commission expires 3-12-67

RECEIVED  
STATE CORPORATION COMMISSION

OCT 12 1964  
10-12-1964  
CONSERVATION DIVISION  
Wichita, Kansas