

15-063-19007-0000


STATE OF KANSAS
STATE CORPORATION COMMISSION

Give All Information Completely
Make Required Affidavit
Mail or Deliver Report to:
Conservation Division
State Corporation Commission
211 No. Broadway
Wichita, Kansas

WELL PLUGGING RECORD

Gove County. Sec. 36 Twp. 12S Rge. 28W (W)
Location as "NE/CNW/SE/SW" or footage from lines. C SW NE
Lease Owner D. R. Lauck Oil Company, Inc.
Lease Name Martin Well No. 2
Office Address 301 S. Broadway, Wichita, Kansas
Character of Well (completed as Oil, Gas or Dry Hole) Dry Hole
Date well completed September 28, 1965
Application for plugging filed September 28, 1965
Application for plugging approved September 28, 1965
Plugging commenced September 28, 1965
Plugging completed September 28, 1965
Reason for abandonment of well or producing formation Dry Hole

NORTH

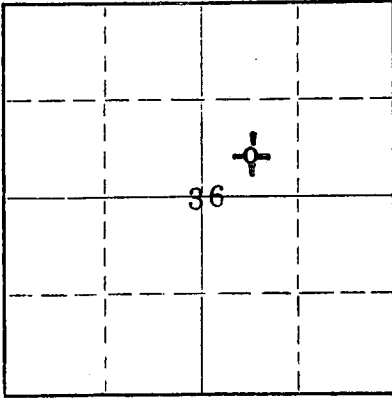

Locate well correctly on above Section Plat

If a producing well is abandoned, date of last production _____ 19____
Was permission obtained from the Conservation Division or its agents before plugging was commenced? Yes

Name of Conservation Agent who supervised plugging of this well Bill Nichols
Producing formation _____ Depth to top _____ Bottom _____ Total Depth of Well 4445 Feet
Show depth and thickness of all water, oil and gas formations.

OIL, GAS OR WATER RECORDS

CASING RECORD

FORMATION	CONTENT	FROM	TO	SIZE	PUT IN	PULLED OUT
		0'	216'	8-5/8"	216'	None

Describe in detail the manner in which the well was plugged, indicating where the mud fluid was placed and the method or methods used in introducing it into the hole. If cement or other plugs were used, state the character of same and depth placed, from _____ feet to _____ feet for each plug set.

4445'-465' Mud
465'-461' Plug
461'-421' Cement, 20 sacks
421'-207' Mud
207'-203' Plug
203'-163' Cement, 20 sacks
163'- 40' Mud
40'- 36' Plug
36'- 6' Cement, 10 sacks
(Bottom of cellar)

RECEIVED
STATE CORPORATION COMMISSION
OCT 6 1965
10-06-1965
CONSERVATION DIVISION
WICHITA, KANSAS

(If additional description is necessary, use BACK of this sheet)
Name of Plugging Contractor Lauck Drilling Company, Incorporated
Address 301 S. Broadway, Wichita, Kansas

STATE OF KANSAS, COUNTY OF SEDGWICK, ss.
John H. Knightley (employee of owner) or (owner or operator) of the above-described well, being first duly sworn on oath, says: That I have knowledge of the facts, statements, and matters herein contained and the log of the above-described well as filed and that the same are true and correct. So help me God.

(Signature) John H. Knightley
301 S. Broadway, Wichita, Kansas
(Address)

SUBSCRIBED AND SWORN to before me this 4th day of October, 19 65

My commission expires March 12, 1967

Stella J. Lips
Notary Public.

15-063-19007-00-00

D. R. Lauck Oil Company, Inc.

Martin #2

C SW NE Sec. 36-12S-28W
Gove County, Kansas

RECEIVED
STATE CORPORATION COMMISSION

OCT 6 1965
10-06-1965
CONSERVATION DIVISION
Wichita, Kansas

Commenced: September 16, 1965
Completed: September 28, 1965

Casing Record: 216' 8-5/8" Cemented with 165 sacks Cement,
3 sacks Calcium Chloride.

Elevation: 2574 GL; 2577 DF; 2579 KB.

Drillers Log

Tops

Shale	800
Sand	950
Shale	1415
Shale & Lime	1639
Sand & Shale	1795
Shale & Shells	2059
Anhydrite	2135
Shale & Lime	2500
Lime & Shale	2650
Shale & Lime	2840
Lime & Shale	3100
Lime	3195
Lime & Shale	3285
Shale & Lime	3440
Lime & Shale	3530
Shale & Lime	3660
Lime & Shale	3758
Lime	3960
Lime, cherty	4005
Lime	4039
Lime & Shale	4135
Lime	4195
Shale & Lime	4266
Lime	4393
Dolomite	4445 RTD

	Samples	Wellex
Heebner	3724-1145	3719-1140
Toronto	3745-1166	3743-1164
Lansing	3764-1185	3762-1183
B. Kansas City	4049-1470	4039-1460
Marmaton	4073-1494	4071-1492
Cherokee Shale	4241-1662	4236-1657
Conglomerate	4335-1756	4332-1753
Mississippian	4344-1765	4342-1763
Warsaw	4344-1765	4342-1763
Osage	4368-1789	4370-1791
Total Depth	4445-1866	4444-1865

DST #1 (S) 4328-55, open 1 hr., weak blow 20 min., very weak blow 40 min. Recovered 57' oil & gas-cut mud with estimated 1 gallon free oil in tool. ISIP 838#, 30 min. FSIP 219#, 30 min. IFP 28#. FFP 38#.

DST #2 (S) 4328-65, open 1 hr., weak blow 40 min., weak intermittent blow 20 min. Recovered 70' slightly oil & gas-cut mud. ISIP 1466#, 30 min. FSIP 727#, 30 min. IFP 19#. FFP 47#.

DST #3 (S) 4327-80, open 1 hr., weak blow 35 min., weak intermittent blow 25 min. Recovered 40' drilling mud. ISIP 1355#, 30 min. FSIP 783#, 30 min. IFP 19#. FFP 47#.

D&A

I hereby certify that this is a true and correct log of the above mentioned well, to the best of my knowledge and belief.

Subscribed and sworn to before me this

5th day of October 1965.

Stella J. Lipps
Notary Public

My commission expires 3-12-67