

STATE OF KANSAS
STATE CORPORATION COMMISSION

15-063-20377-0000

WELL PLUGGING RECORD

Give All Information Completely
Make Required Affidavit
Mail or Deliver Report to
Conservation Division
State Corporation Comm.
245 North Water
Wichita, KS 67202

Gove County, Sec. 2 Twp. 12 Rge. 30 N/W
Location as "NE/CNW $\frac{1}{4}$ SW $\frac{1}{4}$ " or footage from lines
SE NW

Lease Owner H W COBERLY TRUST

Lease Name HEIER Well No. 1

Office Address GOVE, KANSAS 67736

Character of Well (Completed as Oil, Gas or Dry Hole)

DRY HOLE

Date Well completed 7/19/78 19

Application for plugging filed 7/19/78 19

Application for plugging approved 7/19/78 19

Plugging commenced 7/19/78 19

Plugging completed 7/19/78 19

Reason for abandonment of well or producing formation
TOO LOW STRUCTURALLY


If a producing well is abandoned, date of last production
19

Was permission obtained from the Conservation Division or
its agents before plugging was commenced? YES

Name of Conservation Agent who supervised plugging of this well GILBERT BALTHAZOR, PALCO,

Producing formation Depth to top Bottom Total Depth of Well 4525

Show depth and thickness of all water, oil and gas formations.

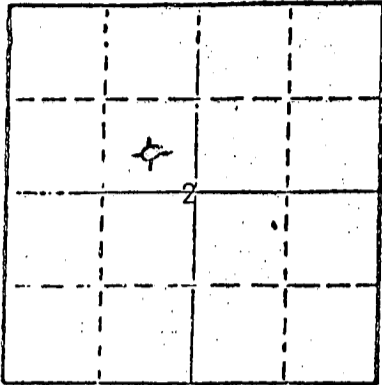

Locate well correctly on above
Section Plat

OIL, GAS OR WATER RECORDS

CASING RECORD

FORMATION	CONTENT	FROM	TO	SIZE	PUT IN	PULLED OUT
				8 5/8"	243.35	NONE

Describe in detail the manner in which the well was plugged, indicating where the mud fluid
was placed and the method or methods used in introducing it into the hold. If cement or other
plugs were used, state the character of same and depth placed, from _____ feet to
_____ feet for each plug set.

FILLED WITH HEAVY MUD TO 1250'. SET PLUG.
PUT IN 70 SACKS CEMENT. FILLED WITH
HEAVY MUD TO 270'. SET PLUG PUT IN
20 SACKS CEMENT. FILLED WITH HEAVY
MUD TO 40'. SET PLUG. FILLED TO TOP
WITH 10 SACKS CEMENT.

(If additional description is necessary, use BACK of this sheet)

Name of Plugging Contractor C-G DRILLING CO., INC.

STATE OF KANSAS COUNTY OF SEDGWICK, ss.
G F GALLOWAY (Notary Public) or (owner or operator)


of the above-described well, being first duly sworn on oath, says: That I have knowledge of
the facts, statements, and matters herein contained and the log of the above-described well
as filed and that the same are true and correct. So help me God.

(Signature) G F Galloway
G F GALLOWAY, 1107 DOUGLAS BLDG, WICHITA
KS 67202 (Address)

SUBSCRIBED AND SWORN TO before me this 24th day of JULY, 1978

Debra L Heersche
Debra L Heersche Notary Public.

My commission expires March 3, 1980

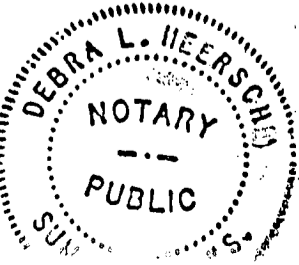

RECEIVED
STATE CORPORATION COMMISSION

SEP 27 1978
09-27-1978
CONSERVATION DIVISION
Wichita, Kansas