

STATE CORPORATION COMMISSION OF KANSAS  
OIL & GAS CONSERVATION DIVISION  
WELL COMPLETION OR RECOMPLETION FORM  
ACO-1 WELL HISTORY  
DESCRIPTION OF WELL AND LEASE

Operator: License # 8996  
Name MID CONTINENT RESOURCES INC  
Address 2805 BENTBAY CIRCLE  
City/State/Zip WICHITA, KANSAS 67204

Purchaser KOCH OIL

Operator Contact Person DON V. RIDER  
Phone 316 838-9069

Contractor: License # 6033  
Name MURFIN DRILLING COMPANY

Wellsite Geologist DON V. RIDER  
Phone 316 838-9069

Designate Type of Completion DUAL COMPLETION  
 New Well  Re-Entry  Workover

Oil  SWD  Temp Abd  
 Gas  Inj  Delayed Comp.  
 Dry  Other (Core, Water Supply etc.)

If OWO: old well info as follows:  
Operator  
Well Name  
Comp. Date Old Total Depth

WELL HISTORY

Drilling Method:  
 Mud Rotary  Air Rotary  Cable  
5-12-86 5-20-86 6-14-86  
Spud Date Date Reached TD Completion Date  
5352' 5298'  
Total Depth PBDT

Amount of Surface Pipe Set and Cemented at 330 feet  
Multiple Stage Cementing Collar Used?  Yes  No  
If yes, show depth set 2566 feet  
If alternate 2 completion, cement circulated from 2566 feet depth to surface 450 SX cmt  
Cement Company Name B.I. TITAN  
Invoice # 281496

API NO. 15-193-20,404-0000  
County THOMAS  
S/2 NW SW Sec 31 Twp 10 Rge 31 East West

1650' Ft North from Southeast Corner of Section  
4620' Ft West from Southeast Corner of Section  
(Note: Locate well in section plat below)


Lease Name MOORHOUSS Well # 7

Field Name CAMPUS NORTH

Producing Formation LANSING, KANSAS CITY

Elevation: Ground 3041 KB 3046

Section Plat

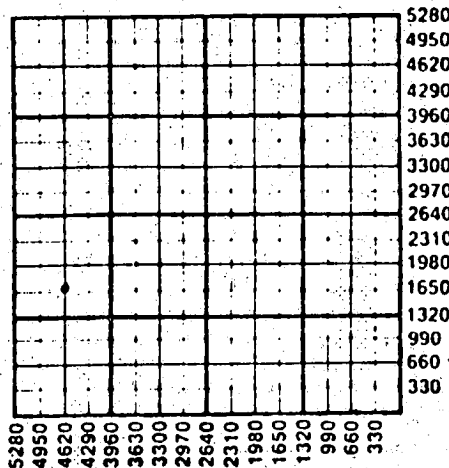

WATER SUPPLY INFORMATION

Disposition of Produced Water:  Disposal  
Docket #  Repressuring

Questions on this portion of the ACO-1 call:  
Water Resources Board (913) 296-3717

Source of Water:  
Division of Water Resources Permit #

Groundwater.....Ft North from Southeast Corner  
(Well) .....Ft West from Southeast Corner of  
Sec Twp Rge East West

Surface Water.....Ft North from Southeast Corner  
(Stream, pond etc).....Ft West from Southeast Corner  
Sec Twp Rge East West

Other (explain).....  
(purchased from city, R.W.D. #)

INSTRUCTIONS: This form shall be completed in duplicate and filed with the Kansas Corporation Commission, 200 Colorado Derby Building, Wichita, Kansas 67202, within 90 days after completion or recompletion of any well. Rule 82-3-130 and 82-3-107 apply. Information on side two of this form will be held confidential for a period of 12 months if requested in writing and submitted with the form. See rule 82-3-107 for confidentiality in excess of 12 months. One copy of all wireline logs and drillers time log shall be attached with this form. Submit CP-4 form with all plugged wells. Submit CP-111 form with all temporarily abandoned wells.

All requirements of the statutes, rules and regulations promulgated to regulate the oil and gas industry have been fully complied with and the statements herein are complete and correct to the best of my knowledge.


Signature *Don V. Rider*

Title Secretary Date 6-17-86

Subscribed and sworn to before me this 17th day of June 1986

Notary Public *Bette I. Rider*

Date Commission Expires 10-1-88

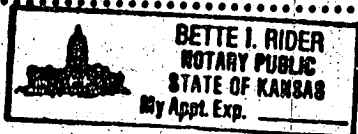

K.C.C. OFFICE USE ONLY  
 Letter of Confidentiality Attached  
 Wireline Log Received  
 Drillers Timelog Received  
Distribution  
 KCC  SWD/Rep  NGPA  
 KGS  Other  
RECEIVED  
STATE CORPORATION COMMISSION (Specify)  
JUN 17 1986

Form ACO-1 (7-84)  
CONSERVATION DIVISION  
Wichita, Kansas

6-17-86

Sec 31 Twp 10 Rge 31 E