

1st Cor

15-033-20942-00-00

FORM C-1 7/91

FOR KCC USE:

FORM MUST BE TYPED

EFFECTIVE DATE: 10-11-97

State of Kansas

FORM MUST BE SIGNED

DISTRICT # 1
SGA? Yes No

NOTICE OF INTENTION TO DRILL

ALL BLANKS MUST BE FILLED

Must be approved by the K.C.C. five (5) days prior to commencing well.

Expected Spud Date 10 month 30 day 97 year

Spot * Ap. E2-NW-SE-NW.. Sec 34.. Twp 34.. S, Rg 20. X East West

OPERATOR: License # 4145
Name: ..Roberts and Murphy, Inc.
Address: ..Post Office Box 7125
City/State/Zip: Shreveport, LA 71137-7125
Contact Person: Scott Martin
Phone: ..(318) 221-8601

*1700 feet from South (North) line of Section
*2630 feet from East (West) line of Section
IS SECTION XX REGULAR IRREGULAR?

(NOTE: Locate well on the Section Plat on Reverse Side)

County: Comanche
Lease Name: Miller Well #: 6-34
Field Name: Box Ranch

CONTRACTOR: License #: 5929
Name: ..Duke Drilling Co., Inc.

Is this a Prorated/Spaced Field? yes XX no
Target formation(s): Arbuckle

Well Drilled For: Well Class: Type Equipment:
XX Oil ... Enh Rec XX Infield XX Mud Rotary
... Gas ... Storage ... Pool Ext. ... Air Rotary
... OWWO ... Disposal ... Wildcat ... Cable
... Seismic; ... # of Holes ... Other

* Nearest lease or unit boundary: *670'
* Ground Surface Elevation: Approx. *1726 feet MSL
Water well within one-quarter mile: yes XX no
Public water supply well within one mile: yes XX no

If OWWO: old well information as follows:
Operator: ..
Well Name: ..
Comp. Date: .. Old Total Depth ..

Depth to bottom of fresh water: 100' ✓
Depth to bottom of usable water: 180' ✓
Surface Pipe by Alternate: X. 1 2
Length of Surface Pipe Planned to be set: 650'
Length of Conductor pipe required: 80'

Directional, Deviated or Horizontal wellbore? yes XX no
If yes, true vertical depth: ..
Bottom Hole Location: ..

* Projected Total Depth: *6830
Formation at Total Depth: Arbuckle
Water Source for Drilling Operations:
... well ... farm pond XX other

Will Cores Be Taken? yes XX no
If yes, proposed zone: RECEIVED

KANSAS CORPORATION COMMISSION

WAS: 1970' FWL; 2515' FWL; 785' FWL;
1715' EST G.L.; PTD 6750'

AFFIDAVIT

10-17-1997
OCT 17 1997

The undersigned hereby affirms that the drilling, completion and eventual plugging of this well will comply with K.S.A. 55-101, et. seq.

It is agreed that the following minimum requirements will be met:

CONSERVATION DIVISION
WICHITA, KS

- 1. Notify the appropriate district office prior to spudding of well;
- 2. A copy of the approved notice of intent to drill shall be posted on each drilling rig;
- 3. The minimum amount of surface pipe as specified below shall be set by circulating cement to the top; in all cases surface pipe shall be set through all unconsolidated materials plus a minimum of 20 feet into the underlying formation;
- 4. If the well is dry hole, an agreement between the operator and the district office on plug length and placement is necessary prior to plugging;
- 5. The appropriate district office will be notified before well is either plugged or production casing is cemented in;
- 6. IF AN ALTERNATE II COMPLETION, PRODUCTION PIPE SHALL BE CEMENTED FROM BELOW ANY USABLE WATER TO SURFACE WITHIN 120 DAYS OF SPUD DATE. IN ALL CASES, NOTIFY DISTRICT OFFICE PRIOR TO ANY CEMENTING.

I hereby certify that the statements made herein are true and to the best of my knowledge and belief.

Date: 10/15/97 Signature of Operator or Agent: Scott Martin Title: Geologist

FOR KCC USE:
API # 15-033-209420000
Conductor pipe required 1705 feet
Minimum surface pipe required 200 feet per Alt. 1 X
Approved by: DW 10-17-97 / ORIG JK 10-6-97
This authorization expires: 4-6-98
(This authorization void if drilling not started within 6 months of effective date.)
Spud date: Agent:

34
34
20w

- REMEMBER TO:
- File Drill Pit Application (form CDP-1) with Intent to Drill;
 - File Completion Form ACO-1 within 120 days of spud date;
 - File acreage attribution plat according to field proration orders;
 - Notify appropriate district office 48 hours prior to workover or re-entry;
 - Submit plugging report (CP-4) after plugging is completed;
 - Obtain written approval before disposing or injecting salt water.

Mail to: KCC - Conservation Division, 130 S. Market - Room 2078, Wichita, Kansas 67202.

IN ALL CASES PLOT THE INTENDED WELL ON THE PLAT BELOW

PLAT OF ACREAGE ATTRIBUTABLE TO A WELL IN A PRORATED OR SPACED FIELD

If the intended well is in a prorated or spaced field, please fully complete this side of the form. If the intended well is in a prorated or spaced field complete the plat below showing that the well will be properly located in relationship to other wells producing from the common source of supply. Please show all the wells within 1 mile of the boundaries of the proposed acreage attribution unit for gas wells and within 1/2 mile of the boundaries of the proposed acreage attribution unit for oil wells.

API NO. 15- 033-209420000
 OPERATOR Roberts and Murphy, Inc.
 LEASE Miller
 WELL NUMBER 6-34
 FIELD Box Ranch

LOCATION OF WELL: COUNTY Comanche
 *1700 feet from south/north line of section
 *2630 feet from east/west line of section
 SECTION 34 TWP 34 RG 20


NUMBER OF ACRES ATTRIBUTABLE TO WELL _____
 QTR/QTR/QTR OF ACREAGE _____

IS SECTION XX REGULAR or _____ IRREGULAR
IF SECTION IS IRREGULAR, LOCATE WELL FROM NEAREST CORNER BOUNDARY.


Section corner used: _____ NE _____ NW _____ SE _____ SW

PLAT

(Show location of the well and shade attributable acreage for prorated or spaced wells.)
 (Show footage to the nearest lease or unit boundary line.)

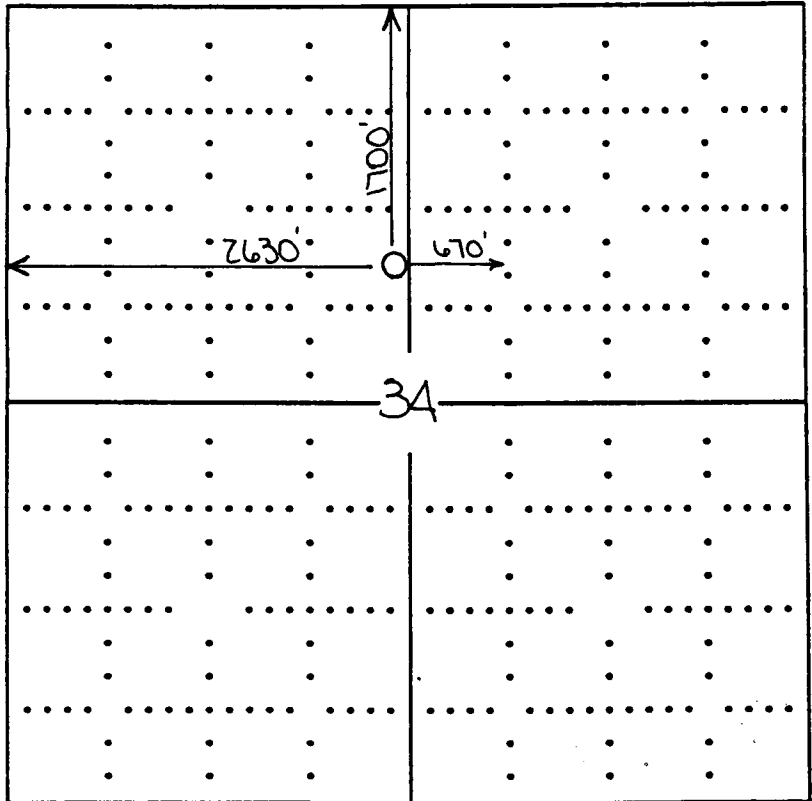


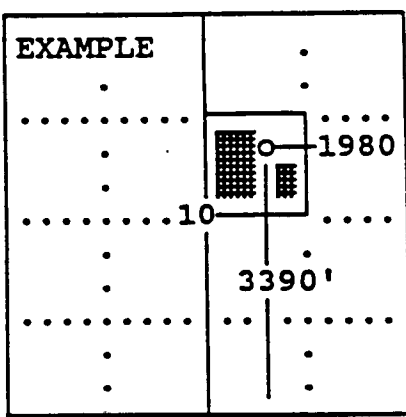

SEWARD CO.

In plotting the proposed location of the well, you must show:

- 1) The manner in which you are using the depicted plat by identifying section lines, i.e. 1 section, 1 section with 8 surrounding sections, 4 sections, etc.;
- 2) the distance of the proposed drilling location from the section's south/north and east/west; and
- 3) the distance to the nearest lease or unit boundary line.