

CARD MUST BE TYPED

State of Kansas

CARD MUST BE SIGNED

# NOTICE OF INTENTION TO DRILL

(see rules on reverse side)

✓ DA

Expected Spud Date..... 8      16      88  
   month      day      year

API Number 15— 063 - 21, 218 - 00 - 00

OPERATOR: License # 5123  
Name Pickrell Drilling Company, Inc.  
Address 110 N. Market, Suite 205  
City/State/Zip Wichita, KS 67202  
Contact Person Jay McNeil  
Phone 262-8427

SE NW Sec 21 Twp 12 S, Rg 30 — East  
3300 Ft. from South Line of Section  
3300 Ft. from East Line of Section

(Note: Locate well on Section Plat on reverse side)

CONTRACTOR: License # 5123  
Name Pickrell Drilling Company, Inc.  
City/State Wichita, Kansas

Nearest lease or unit boundary line 660 feet  
County Gove  
Lease Name Ward Trust Well # 1-A

Well Drilled For:      Well Class:      Type Equipment:  
 Oil      \_\_\_ Storage      \_\_\_ Infield       Mud Rotary  
\_\_\_ Gas      \_\_\_ Inj      \_\_\_ Pool Ext.      \_\_\_ Air Rotary  
\_\_\_ OWWO      \_\_\_ Expl       Wildcat      \_\_\_ Cable

Ground surface elevation 2837 feet MSL  
Domestic well within 330 feet:      \_\_\_ yes       no  
Municipal well within one mile:      \_\_\_ yes       no  
Depth to bottom of fresh water 80 100  
Depth to bottom of usable water 200 1350  
Surface pipe by Alternate:      1 \_\_\_ 2

If OWWO: old well info as follows:

Operator .....  
Well Name .....  
Comp Date ..... Old Total Depth .....

Surface pipe planned to be set 300'  
Conductor pipe required .....  
Projected Total Depth 4550 feet  
Formation Mississippian

I certify that well will comply with K.S.A. 55-101, et seq., plus eventually plugging hole to KCC specifications.

Date 8-10-88 ..... Signature of Operator or Agent *[Signature]* Title Chief Geologist

For KCC Use:

Conductor Pipe Required ..... feet; Minimum Surface Pipe Required 200' feet per Alt.  (2)  
This Authorization Expires 2-10-89 ..... Approved By LKM 8-10-88


EFFECTIVE DATE: 8-15-88

Must be filed with the K.C.C. five (5) days prior to commencing well  
This card void if drilling not started within six (6) months of date received by K.C.C.

Important procedures to follow:

1. Notify District office before setting surface casing.
2. Set surface casing by circulating cement to the top.
3. File completion forms ACO-1 with K.C.C. within 120 days of well spud date, following instructions on ACO-1, side 1, and including copies of wireline logs.
4. Notify District office 48 hours prior to old well workover or re-entry.
5. Prior to filing Intent, prepare a proposed plugging plan in case well is D & A, then obtain approval of plan when calling district office prior to setting surface pipe.
6. Submit plugging report (CP-4) to K.C.C. after plugging is completed.
7. Obtain an approved injection docket number before disposing of salt water.
8. Notify K.C.C. within 10 days when injection commences or terminates.
9. In alternate 2 completion, cement in the production pipe from below any usable water to surface within 120 days of spud date.

A Regular Section of Land  
1 Mile = 5,280 Ft.

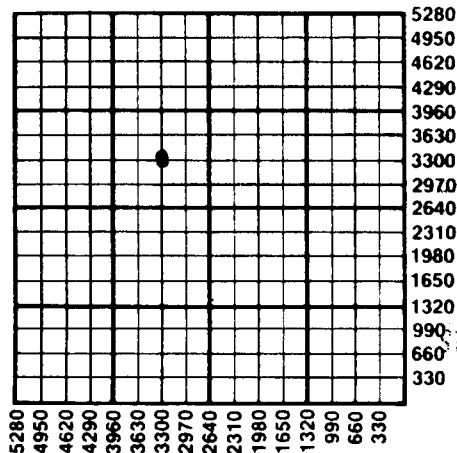

RECEIVED  
STATE CORPORATION COMMISSION  
WICHITA, KANSAS

AUG 10 1988

CONSERVATION DIVISION  
Wichita, Kansas

08-10-1988

State Corporation Commission of Kansas  
Conservation Division  
200 Colorado Derby Building  
Wichita, Kansas 67202-1212  
(316) 263-3238