

STATE OF KANSAS
STATE CORPORATION COMMISSION

Form CP-4

Give All Information Completely
Make Required Affidavit
Mail or Deliver Report to:
Conservation Division
State Corporation Commission
212 No. Market
Wichita, Kansas 67202

WELL PLUGGING RECORD

Ellis County, Sec. 24 Twp. 11S Rge. (E) 17 (W)

Location as "NE/CNW/SW" or footage from lines 330' FNL & 1320' FWL

Lease Owner Cities Service Oil Company

Lease Name Colahan "A" Well No. 6

Office Address Box 553 Russell, Kansas 67665

Character of Well (completed as Oil, Gas or Dry Hole) Oil

Date well completed 12-18 19 39

Application for plugging filed 5-24 19 71

Application for plugging approved 5-25 19 71


Plugging commenced 6-8 19 71

Plugging completed 6-11 19 71

Reason for abandonment of well or producing formation Depleted

If a producing well is abandoned, date of last production 10-2 19 69

Was permission obtained from the Conservation Division or its agents before plugging was commenced? Yes

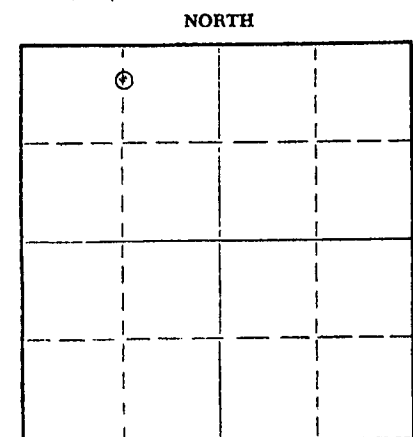

Locate well correctly on above Section Plat

Name of Conservation Agent who supervised plugging of this well Mr. Leo Massey

Producing formation Arbuckle Depth to top 3373' Bottom 10' Pen Total Depth of Well 3383 Feet

Show depth and thickness of all water, oil and gas formations.


OIL, GAS OR WATER RECORDS

CASING RECORD

FORMATION	CONTENT	FROM	TO	SIZE	PUT IN	PULLED OUT
				8 5/8"	1002'	None
				5 1/2"	3374'	1016'

Describe in detail the manner in which the well was plugged, indicating where the mud fluid was placed and the method or methods used in introducing it into the hole. If cement or other plugs were used, state the character of same and depth placed, from _____ feet to _____ feet for each plug set.

Dumped sand into hole filling from 3383' to 3315'
Dumped 5 sacks cement filling 3315' to 3280'
Pulled 31 joints of 5 1/2" casing and welded collar on 8 5/8" pipe
Pumped in mud and fluid filling from 3280' to 1270', 20 sacks gel and 3 sacks hulls filling from 1270' to 550', and pumped in 130 sacks cement filling from 550' to surface. Cut 8 5/8" Collar off and welded on cap.
PLUGGING COMPLETE

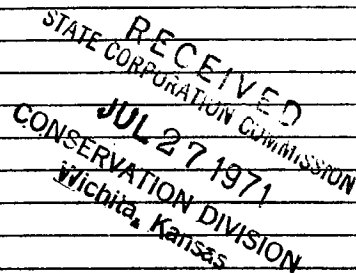

(If additional description is necessary, use BACK of this sheet)

Name of Plugging Contractor Knight Casing Pulling Co., Inc.

Address Chase, Kansas

STATE OF Kansas, COUNTY OF Russell, ss.


H. W. Peterman (employee of owner) or former operator of the above-described well, being first duly sworn on oath, says: That I have knowledge of the facts, statements, and matters herein contained and the log of the above-described well as filed and that the same are true and correct. So help me God.

(Signature) [Handwritten Signature]

Box 553 Russell, Kansas 67665 (Address)


Subscribed and sworn to before me this 26th day of July, 19 71

James A. Kyger Notary Public

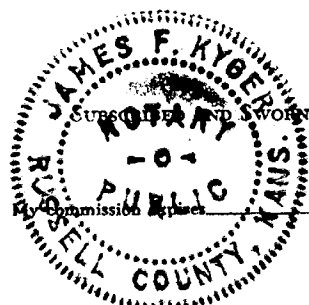

WELL RECORD

15-051-03417-0000

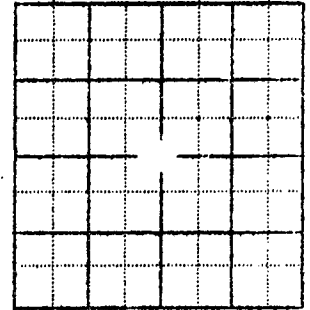

Company Cities Service Oil Co. No. 6 Farm Colehan

Location 330' S & 1320' W of N/4 Cor. Sec. 24 T. 11 R. 17-W

Elevation 1888 County Ellis State Kansas

Drilg. Comm. Nov. 27, 1939 Echo-Motor Potential 3589

Date Completed Dec. 18, 1939 Initial Production oil, 0 wtr., 24 hrs. after

Contractor: J. E. Mabee Company 500 gals. acid.

Total Depth 3383'

CASING RECORD:

8-5/8" 1002' cem. 250 Ashgrove, 25
OilMax & 10 Aquagel
5 1/2" 3374' cem. 100 Ashgrove & 15
Aquagel

Corr. Top Arbuckle 3373
Penetration 10
Total Depth 3383

FORMATION RECORD:

shale & shells 370
sand & shale 636
shale 670
sand 730
shale & shells 1015
shale & red bed 1080
anhydrite lime 1120
lime & shale 1157
shale 1170
shale & shells 1285
red bed & shale 1320
shale & shells 1646
salt & shale 1660
lime & shale 1855
lime broken 1982
lime & shale 2025
lime broken 2143
lime & shale 2205
lime broken 2248
sand 2265
shale & shells 2785
broken lime 2847
lime 2915
lime broken 2948
chert & lime 2960
lime 2995
lime & shale 3035
lime broken 3050
lime 3183
shale & lime 3192
lime 3348
shale & lime 3370
shale 3381
lime 3382

FILLUP: 1100' oil in 35 mins.
1900' oil in 1 1/2 hrs.
2800' oil in 2 hrs. 55 mins.

Acidized with 500 gallons Dowell XX.

SYFO: 500' 1 1/2"
700' 00
900' 10
1250' 10
1500' 00
2000' 00
2500' 10
3000' 00

Rotary O-3374 S.L.M.
Cable Tools 3374-3383

top Arbuckle 3381
3382 = 3374 S.L.M.
dolomite 3383 T. D.

RECEIVED
STATE CORPORATION COMMISSION
MAY 25 1971
CONSERVATION DIVISION
Wichita, Kansas