

TO:
STATE CORPORATION COMMISSION
CONSERVATION DIVISION - PLUGGING
130 SOUTH MARKET, SUITE 2078
WICHITA, KANSAS 67202

API Well Number: 15-063-21844-00-00
Spot: NESWSWNW Sec/Twnshp/Rge: 1-13S-28W
2118 feet from N Section Line, 603 feet from W Section Line
Lease Name: ZIMMERMAN Well #: 1
County: GOVE Total Vertical Depth: 4550 feet

Operator License No.: 33268
Op Name: RL INVESTMENT, LLC
Address: 217 SAINT PETER ST
MORLAND, KS 67650

String	Size	Depth (ft)	Pulled (ft)	Comments
SURF	8.625	230		

Well Type: DH UIC Docket No: _____ Date/Time to Plug: 06/01/2010 11:00 PM
Plug Co. License No.: 33575 Plug Co. Name: WW DRILLING, LLC
Proposal Rcvd. from: KIRBY Company: RL INVESTMENT, LLC Phone: (785) 627-5711

Proposed Plugging Method: Ordered 205 sxs 60/40 pozmix - 4% gel with 1/4# flocele per sack.
Space all plugs with heavy drilling mud through drill pipe.

Plugging Proposal Received By: DAVID WANN WitnessType: NONE
Date/Time Plugging Completed: 06/02/2010 12:00 AM KCC Agent: DAVID WANN

Actual Plugging Report:

1st. Plug at 2080' w/25 sxs.
2nd. Plug at 1150' w/100 sxs.
3rd. Plug at 280' w/40 sxs.
4th. Plug at 40' w/10 sxs.
Rathole with 30 sxs.

Perfs:

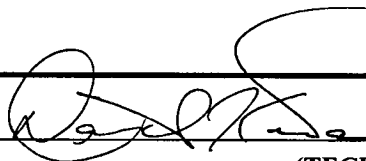
6/07/10
2010061226

RECEIVED
JUN 04 2010
KCC WICHITA

Remarks: S.O.S. CEMENTING COMPANY.

Plugged through: DP

District: 04

Signed  (TECHNICIAN)

CM