

CARD MUST BE TYPED

State of Kansas

Corrected CARD MUST BE SIGNED

NOTICE OF INTENTION TO DRILL

*The prod. csg. will be cmtd. from below usable wtr. to surface immediately upon completion.

(see rules on reverse side)

CORRECTED COPY -

Note change in spelling of Lease Name

Starting Date August 10, 1985
month day year

API Number 15— 109-20,390-00-00

OPERATOR: License # 5181
Name SLAWSON, DONALD C.
Address 200 Douglas Bldg.
City/State/Zip Wichita, KS 67202
Contact Person Bill Horigan
Phone (316) 263-3201

— East
SW NE SE Sec. 28 Twp. 12 S, Rg. 33 West
1650 Ft. from South Line of Section
990 Ft. from East Line of Section


(Note: Locate well on Section Plat on reverse side)

CONTRACTOR: License # 5657
Name SLAWSON DRILLING CO.
City/State Wichita, KS

Nearest lease or unit boundary line 990 feet
County Logan

* Lease Name Roooms 'B' Well # 1
Ground surface elevation 3116 feet MSL

Well Drilled For: Well Class: Type Equipment:
 Oil SWD Infield Mud Rotary
 Gas Inj Pool Ext. Air Rotary
 OWWO Expl Wildcat Cable

Domestic well within 330 feet: yes no
Municipal well within one mile: yes no
Surface pipe by Alternate: 1 2 
Depth to bottom of fresh water 190'
Depth to bottom of usable water Dakota 1600
Surface pipe planned to be set 400'
Projected Total Depth 4750 feet
Formation Miss.

If OWWO: old well info as follows:

Operator
Well Name
Comp Date Old Total Depth.....

I certify that well will comply with K.S.A. 55-101, et seq., plus eventually plugging hole to KCC specifications. *was: Rooms 'B'*


Date 7-30-85 Signature of Operator or Agent *Robert B. Jenkins* Title *W. Dist Geol*
Robert B. Jenkins Western District Geologist

For KCC Use:
Conductor Pipe Required feet; Minimum Surface Pipe Required feet per Alt. 1 2
This Authorization Expires 2-1-86 Approved By *8-1-85*

Must be filed with the K.C.C. five (5) days prior to commencing well
This card void if drilling not started within six (6) months of date received by K.C.C.

*Circulate alternate cementing material per
82-3-106(b)4.

A Regular Section of Land
1 Mile = 5,280 Ft.

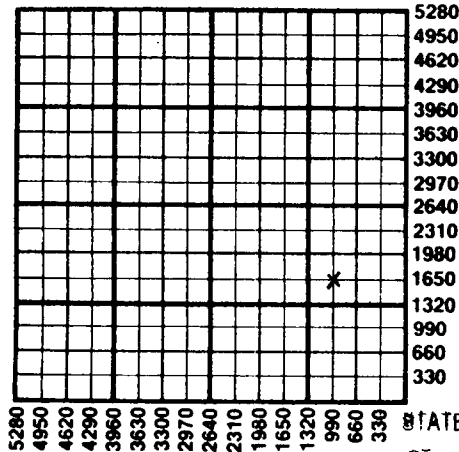

Important procedures to follow:

1. Notify District office before setting surface casing.
2. Set surface casing by circulating cement to the top.
3. File completion forms ACO-1 with K.C.C. within 90 days of well completion, following instructions on ACO-1, side 1, and including copies of wireline logs.
4. Notify District office 48 hours prior to old well workover or re-entry.
5. Prior to filing Intent, prepare a proposed plugging plan in case well is D & A, then obtain approval of plan when calling district office prior to setting surface pipe.
6. Submit plugging report (CP-4) to K.C.C. after plugging is completed.
7. Obtain an approved injection docket number before disposing of salt water.
8. Notify K.C.C. within 10 days when injection commences or terminates.

RECEIVED
STATE CORPORATION COMMISSION

AUG 1 1985
08-01-1985
CONSERVATION DIVISION
Wichita, Kansas

9. If an alternate 2 completion, cement in the production pipe from below any usable water to surface within 120 days of spud date.

State Corporation Commission of Kansas
Conservation Division
200 Colorado Derby Building
Wichita, Kansas 67202
(316) 263-3238