


WELL PLUGGING RECORD

Give All Information Completely
Make Required Affidavit
Mail or Deliver Report to:
Conservation Division
State Corporation Commission
212 North Market, Insurance Bldg.
Wichita, Kansas

Logan County, Sec. 23 Twp. 12S Rge. (E) 34 (W)
Location as "NE/CNW/SW" or footage from lines NW SW
Lease Owner Arvel C. Smith
Lease Name Van Eaton Well No. 1
Office Address 569 Stratford Road, Wichita 6, Kansas
Character of Well (completed as Oil, Gas or Dry Hole) Dry Hole
Date well completed April 4, 19 62
Application for plugging filed " " 19 " "
Application for plugging approved " " 19 " "
Plugging commenced " " 19 " "
Plugging completed " " 19 " "
Reason for abandonment of well or producing formation Dry Hole

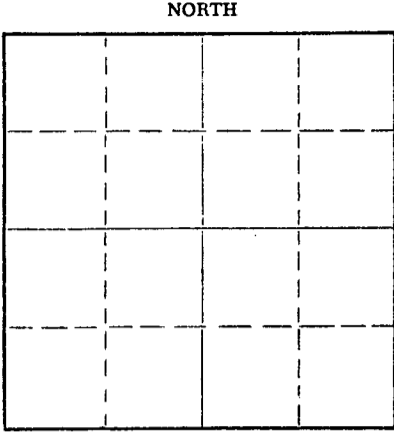

Locate well correctly on above Section Plat

If a producing well is abandoned, date of last production 19
Was permission obtained from the Conservation Division or its agents before plugging was commenced? Yes

Name of Conservation Agent who supervised plugging of this well Eldon Petty
Producing formation _____ Depth to top _____ Bottom _____ Total Depth of Well 4883 Feet
Show depth and thickness of all water, oil and gas formations.

OIL, GAS OR WATER RECORDS

CASING RECORD

FORMATION	CONTENT	FROM	TO	SIZE	PUT IN	PULLED OUT
	Surface Pipe	G.L.	230'	8 5/8"		No

Describe in detail the manner in which the well was plugged, indicating where the mud fluid was placed and the method or methods used in introducing it into the hole. If cement or other plugs were used, state the character of same and depth placed, from _____ feet to _____ feet for each plug set.

Surface to 30' -- 10 sack Cement plug
30' to 170' -- Mud
170' to 200' -- 10 sack Cement plug
200' to 300' -- Mud
300' to 390' -- 30 sack Cement plug
390' to 505' -- Mud
505' to 580' -- 25 sack Cement plug
580' to 900' -- Mud
900' to 1020' -- 40 sack Cement plug
1020' to T.D. -- Mud.

RECEIVED
STATE CORPORATION COMMISSION

APR 10 1962
04-10-1962
CONSERVATION DIVISION
WICHITA

(If additional description is necessary, use BACK of this sheet)

Name of Plugging Contractor Natural Gas Drilling, Inc.
Address P.O. Box 1615, Oklahoma City, Oklahoma

STATE OF Kansas, COUNTY OF Sedgwick, ss.
Arvel C. Smith (employee of owner) or (owner or operator) of the above-described well, being first duly sworn on oath, says: That I have knowledge of the facts, statements, and matters herein contained and the log of the above-described well as filed and that the same are true and correct. So help me God.

(Signature) Arvel C. Smith
Arvel C. Smith
569 Stratford Road, Wichita 6, Kansas
(Address)

SUBSCRIBED AND SWORN TO before me this 9th day of April, 1962

My commission expires October 11, 1964

Ethel Morray
Ethel Morray Notary Public.



15-109-30052-00-00


WELL LOG BUREAU—KANSAS GEOLOGICAL SOCIETY
508 East Murdock, Wichita, Kansas

Company- ARVEL C. SMITH
Farm- Van Eaton No. 1

SEC. 23 T. 12 R. 34W
C NW SW

Total Depth. 4883'
Comm. 3-8-62 Comp. 4-4-62
Shot or Treated.
Contractor. Natural Gas Drlg.
Issued. 7-21-62

County Logan KANSAS

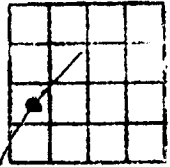

8 5/8" CASING
241' cem w/150 sx.

Elevation. 3175' DF

Production. Dry

Figures indicate Bottom of Formations.

shale & sand	640
shale & lime	1530
shale, sand, broken lime	1940
shale & anhydrite	2400
shale & sand	2830
lime & shale	3180
shaly lime & sand	3440
lime with chert	3460
lime & shale	3650
lime & sandy shale	3750
sandy lime & chalk	3840
sandy lime	3890
lime	4175
lime & shale	4570
lime & chert	4630
sandy shale & lime	4770
lime	4883
Total Depth	

TOBS: SCOUT	
Base Anhydrite	2657
Topeka	3854
Heebner	4045
Toronto	4068
Lansing	4086
Base Kansas City	4404
Marmaton	4419
Cherokee Lime	4575
Cherokee Sand	4765
Mississippi	4786