


15-109 - 20054 - 00 - 00

STATE OF KANSAS
STATE CORPORATION COMMISSION
CONSERVATION DIVISION
P. O. BOX 17027
WICHITA, KANSAS 67217

FORM CP-4

WELL PLUGGING RECORD

Logan County, Sec. 17 Twp. 12S Rge. 34 (W)
Location as "NE/CNW/SW" or footage from lines C SW SE

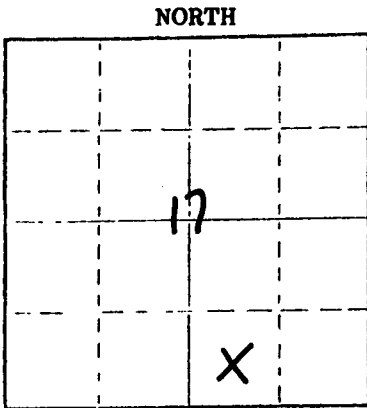

Locate well correctly on above Section Plat

Lease Owner: Mobile C. Hoover
Lease Name: Delton HUBERT ANBRC
Office Address: 302 NBC Building, El Dorado, Arkansas 71730
Well No. #1
Character of Well (completed as Oil, Gas or Dry Hole): Dry Hole
Date well completed: January 9, 1976
Application for plugging filed (verbal): January 9, 1976
Application for plugging approved (verbal): January 9, 1976
Plugging commenced: January 9, 1976
Plugging completed: January 9, 1976
Reason for abandonment of well or producing formation: No commercial quantity of oil or gas encountered.
If a producing well is abandoned, date of last production: 19__
Was permission obtained from the Conservation Division or its agents before plugging was commenced? Yes

Name of Conservation Agent who supervised plugging of this well: Gilbert Balthazor
Producing formation: _____ Depth to top: _____ Bottom: _____ Total Depth of Well: 4773 feet
Show depth and thickness of all water, oil and gas formations.

OIL, GAS OR WATER RECORDS

CASING RECORD

FORMATION	CONTENT	FROM	TO	SIZE	PUT IN	PULLED OUT
				8 5/8"	259'	none

Describe in detail the manner in which the well was plugged, indicating where the mud fluid was placed and the method or methods used in introducing it into the hole. If cement or other plugs were used, state the character of same and depth placed, from _____ feet to _____ feet for each plug set.

1st Plug was Set @ 1300' with 70 sx. cement
2nd Plug was Set @ 250' with 20 sx. cement
3rd Plug was Set @ 40' with 10 sx. cement
RECEIVED
STATE CORPORATION COMMISSION
01-14-1976
JAN 14 1976

CONSERVATION DIVISION
Wichita, Kansas

(If additional description is necessary, use BACK of this sheet)

Name of Plugging Contractor: Abercrombie Drilling, Inc.
Address: 801 Union Center, Wichita, Kansas 67202

STATE OF KANSAS COUNTY OF SEDGWICK, ss.


Jerry A. Langrehr-Exec. V.P. (employee of owner) or (owner or operator) of the above-described well, being first duly sworn on oath, says: That I have knowledge of the facts, statements, and matters herein contained and the log of the above-described well as filed and that the same are true and correct. So help me God.

(Signature) Jerry A. Langrehr
801 Union Center, Wichita, Ks. 67202 (Address)

SUBSCRIBED AND SWORN to before me this 13th day of January, 1976

July 21, 1979

Sandra Richman
Sandra Richman Notary Public.

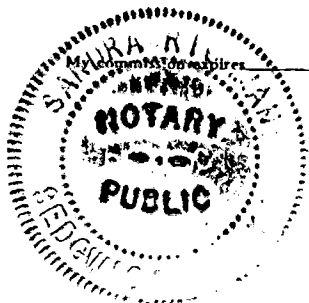

CONTRACTOR'S WELL LOG

15-109-20054-00-00

OPERATOR: Moble C. Hoover
 CONTRACTOR: Abercrombie Drilling, Inc.
 WELL NAME: *Delton* HUBERT #1 *ANB CC*
 LOCATION: C SW SE Section 17-12S-34W
 Logan County, Kansas
 GEOLOGIST: Orlin R. Phelps
 SPUD DATE: December 28, 1975
 COMPLETION DATE: January 9, 1976

Clay, Sand, Shale	0	205
Shale	205	265
Shale & Sand	265	840
Sand & Shale	840	2427
Shale & Lime	2427	2630
Anhydrite	2630	2660
Shale & Lime	2660	2672
Shale	2672	2962
Shale & Lime	2962	3320
Shale	3320	3532
Shale & Lime	3532	4042
Lime	4042	4064
Lime & Shale	4064	4256
Lime	4256	4663
Lime & Shale	4663	4767
Lime	4767	4770
Rotary Total Depth		4770

Spudded in @ 12:30 p.m. December 28, 1975. Cut 265' of 12 1/4" hole. Ran 6 jts. of 8 5/8" casing, tallied 251'. Set @ 259'. Cemented with 175 sx. Sunset Cement. Plug was down @ 5:45 p.m. December 28, 1975.

Plugged and Abandoned: 1st Plug was Set @ 1300' with 70 sx. cement; 2nd Plug was Set @ 250' with 20 sx. cement; 3rd Plug was Set @ 40' with 10 sx. cement. State Plugger: Gilbert Balthazor Plug was down @ 2:00 a.m. January 9, 1976.

SAMPLE TOPS:

Anhydrite 2630'
 B/Anhydrite 2660'

JAN 14 1976
 01-14-1976

STATE OF KANSAS)
) SS
 COUNTY OF SEDGWICK)

Jerry A. Langrehr-Executive Vice President of Abercrombie Drilling, Inc., does hereby state that the above and foregoing is a true and correct copy of the log of the HUBERT #1, C SW SE Section 17-21S-34W, Logan County, Kansas.

ABERCROMBIE DRILLING, INC.

By: *Jerry A. Langrehr*
 Jerry A. Langrehr-Exec. V.P.

Subscribed and sworn to before me, a Notary Public, in and for the aforesaid county and state as of this 13th day of January, 1976.

Sandra Richman
 Sandra Richman - Notary Public

