AMENDED RCVD KCC 02-12-86

SIDE ONE

STATE CORPORATION COMMISSION OF KANSAS
OIL & GAS CONSERVATION DIVISION

WELL COMPLETION OR RECOMPLETION FORM
ACO-1 WELL HISTORY

DESCRIPTION OF WELL AND LEASE

Operator: License # 5181
Name DONALD C. SLAWSON
Address 200 Douglas Building
City/State/Zip Wichita, Kansas 67202

Purchaser Inland Purchasing & Transportation

Operator Contact Person Bill Horigan
Phone (316) 263-3201

Contractor: License # 5657
Name SLAWSON DRILLING CO., INC.

Wellsite Geologist George Mueller
Phone (316) 262-7181

Designate Type of Completion
[X] New Well [ ] Re-Entry [ ] Workover

[X] Oil [ ] SWD [ ] Temp Abd
[ ] Gas [ ] Inj [ ] Delayed Comp.
[ ] Dry [ ] Other (Core, Water Supply etc.)

If OWWO: old well info as follows:
Operator
Well Name
Comp. Date Old Total Depth

API NO. 15- 193-20,390-0000

County Thomas

NE NE NE Sec. 31 Twp. 10 Rge. 32 [ ] East [X] West

4950 Ft North from Southeast Corner of Section
330 Ft West from Southeast Corner of Section
(Note: Locate well in section plat below)

Lease Name Hecker G Well # 1

Field Name Wildcat

Producing Formation KC

Elevation: Ground 3069 KB 3075

Section Plat

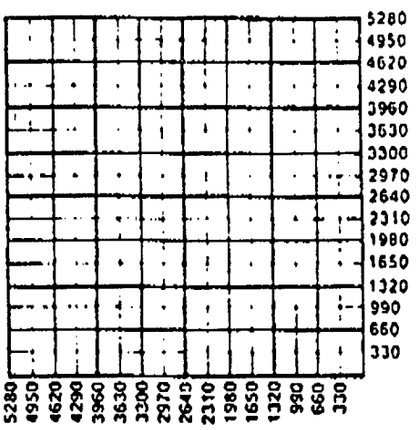

WATER SUPPLY INFORMATION

Disposition of Produced Water: [ ] Disposal
Docket # [ ] Repressuring

Questions on this portion of the ACO-1 call:
Water Resources Board (913) 296-3717

Source of Water:
Division of Water Resources Permit #

[ ] Groundwater Ft North from Southeast Corner
(Well) Ft West from Southeast Corner of
Sec Twp Rge [ ] East [ ] West

[ ] Surface Water Ft North from Southeast Corner
(Stream, pond etc) Ft West from Southeast Corner
Sec Twp Rge [ ] East [ ] West

[ ] Other (explain)
(purchased from city, R.W.D. #)

WELL HISTORY

Drilling Method:
[XX] Mud Rotary [ ] Air Rotary [ ] Cable

1/3/86	1/14/86	1/24/86
Spud Date	Date Reached TD	Completion Date
4675'	4603'	
Total Depth	PBTD	

Amount of Surface Pipe Set and Cemented at 344 feet
Multiple Stage Cementing Collar Used? [X] Yes [ ] No
If yes, show depth set 2581 feet
If alternate 2 completion, cement circulated
from 2581 feet depth to surface w/ 400 SX cmt

INSTRUCTIONS: This form shall be completed in duplicate and filed with the Kansas Corporation Commission, 200 Colorado Derby Building, Wichita, Kansas 67202, within 90 days after completion or recompletion of any well. Rule 82-3-130 and 82-3-107 apply.
Information on side two of this form will be held confidential for a period of 12 months if requested in writing and submitted with the form. See rule 82-3-107 for confidentiality in excess of 12 months.
One copy of all wireline logs and drillers time log shall be attached with this form. Submit CP-4 form with all plugged wells. Submit CP-111 form with all temporarily abandoned wells.

All requirements of the statutes, rules and regulations promulgated to regulate the oil and gas industry have been fully complied with and the statements herein are complete and correct to the best of my knowledge.

Signature W R Horigan
William R. Horigan
Title Kansas Operations Manager Date 2/12/86

Subscribed and sworn to before me this 12th day of February, 19 86
Notary Public Leslie K. Robinson
Leslie K. Robinson
Date Commission Expires 5-27-89

LESLIE K. ROBINSON
NOTARY PUBLIC
STATE OF KANSAS

K.C.C. OFFICE USE ONLY
F [ ] Letter of Confidentiality Attached
C [ ] Wireline Log Received
C [ ] Drillers Timelog Received
Distribution
[ ] KCC [ ] SWD/Rep [ ] NGPA
[ ] KGS [ ] Plug [ ] Other (Specify)

Form ACO-1 (7-84)