

15-109-20131-00-00

STATE OF KANSAS
STATE CORPORATION COMMISSION


WELL PLUGGING RECORD

Give All Information Completely
Make Required Affidavit
Mail or Deliver Report to
Conservation Division
State Corporation Comm.
245 North Water
Wichita, KS 67202

Logan County, Sec. 15 Twp. 12S Rge. 36 E/W
Location as "NE/CNW $\frac{1}{4}$ /SW $\frac{1}{4}$ " or footage from lines _____

SW NE SE
Lease Owner Mull Drilling Co., Inc.
Lease Name Andrews Well No. 1

Office Address 221 N. Main Suite 300 Wichita, Kansas
Character of Well (Completed as Oil, Gas or Dry Hole) _____

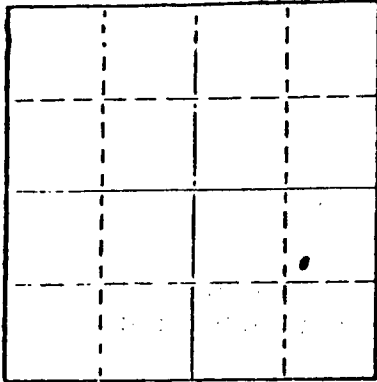

Locate well correctly on above
Section Plat

Dry hole
Date Well completed 6-15 19 79
Application for plugging filed 6-15 19 79
Application for plugging approved 6-15 19 79
Plugging commenced 6-15 19 79
Plugging completed 6-15 19 79
Reason for abandonment of well or producing formation _____

Dry Hole
If a producing well is abandoned, date of last production 19 _____

Was permission obtained from the Conservation Division or its agents before plugging was commenced? yes

Name of Conservation Agent who supervised plugging of this well Gilbert Bolthazor
Producing formation _____ Depth to top _____ Bottom _____ Total Depth of Well _____
Show depth and thickness of all water, oil and gas formations.

OIL, GAS OR WATER RECORDS

CASING RECORD

FORMATION	CONTENT	FROM	TO	SIZE	PUT IN	PULLED OUT
Surface pipe		0'	281'	8 5/8"	273.75'	

Describe in detail the manner in which the well was plugged, indicating where the mud fluid was placed and the method or methods used in introducing it into the hold. If cement or other plugs were used, state the character of same and depth placed, from _____ feet to _____ feet for each plug set.

Plug #1 Set at 1150' with 70 sacks cement

Plug #2 Set at 260' with 20 sacks cement

Plug #3 Set at 40' with 10 sacks cement

RECEIVED
JUN 22 1979

(If additional description is necessary, use BACK of this sheet)

Name of Plugging Contractor Blue Goose Drilling Co., Inc.

STATE OF Kansas COUNTY OF Barton ss.

George E. Miller, Jr. (employee of owner) or (owner or operator) of the above-described


well, being first duly sworn on oath, says: That I have knowledge of the facts, statements, and matters herein contained and the log of the above-described well as filed and that the same are true and correct. So help me God.

(Signature) George E. Miller, Jr.

(Address)

Subscribed and Sworn to before me this 19th day of June 1979

Mary Ann Schwaborn
Notary Public.

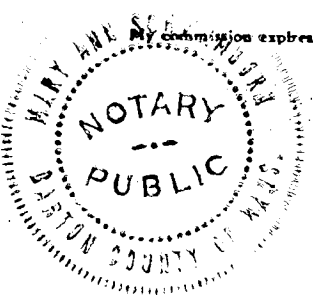

15-109-20131-00-00

WELL LOG
Andrews #1
Sec. 15-12S-36W
Logan County, Kansas

Name of Operator: Mull Drilling Co., Inc.
221 N. Main Suite 300
Wichita, Kansas 67202

Date Completed: June 15, 1979

<u>FROM</u>	<u>TO</u>	
0	284	Surface soil and sand
284	2335	Shale and sand
2335	2564	Shale and lime
2564	2590	Anhydrite
2590	2980	Shale and lime
2980	3820	Shale and sand
3820	4550	Shale and lime
4550	4635	Lime
4635	4750	Shale and lime
4750	4770	Lime
4770		Total Depth

STATE OF KANSAS

COUNTY OF BARTON ss

RECEIVED
STATE OF KANSAS
06-22-1979
JUN 21 1979

George E. Miller, Jr., President of Blue Goose Drilling Co., Inc. being first duly sworn on oath says: That I have knowledge of the facts, statements and matters herein contained and the log of the above described well as filed and that the same are true and correct.

George E. Miller, Jr.
George E. Miller, Jr.

Subscribed and sworn before me this 19th day of June, 1979.

Mary Ann Schwamborn
Notary Public Barton County

My commission expires 8-1-81.

