


WELL PLUGGING RECORD

Give All Information Completely  
Make Required Affidavit  
Mail or Deliver Report to:  
Conservation Division  
State Corporation Commission  
211 No. Broadway  
Wichita, Kansas

NORTH

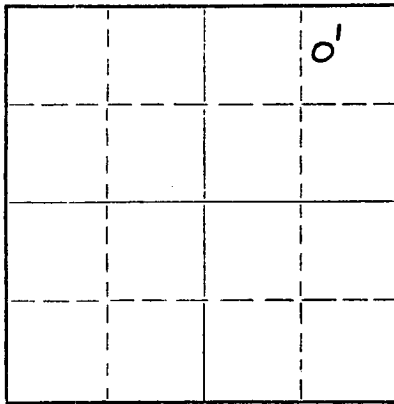

Locate well correctly on above Section Plat

Wallace County. Sec. 15 Twp. 12 Rge. 39 (W)  
Location as "NE/CNW/SW" or footage from lines NE/4 of NE/4  
Lease Owner General Crude Oil Company  
Lease Name Delia F. Adams Well No. 1  
Office Address 107 Oil & Gas Building, Abilene, Texas  
Character of Well (completed as Oil, Gas or Dry Hole) Dry Hole  
Date well completed July 3, 1959  
Application for plugging filed July 2 (Verbal) 1959  
Application for plugging approved July 3 (Verbal) 1959  
Plugging commenced July 2 1959  
Plugging completed July 3 1959  
Reason for abandonment of well or producing formation Dry Hole

If a producing well is abandoned, date of last production None 19    
Was permission obtained from the Conservation Division or its agents before plugging was commenced? Yes

Name of Conservation Agent who supervised plugging of this well A. D. Fabricius, Hill City, Kansas  
Producing formation None Depth to top    Bottom    Total Depth of Well 5030 Feet  
Show depth and thickness of all water, oil and gas formations.

OIL, GAS OR WATER RECORDS

CASING RECORD

FORMATION	CONTENT	FROM	TO	SIZE	PUT IN	PULLED OUT
Surface soil & sand	Water	Surface	75	8-5/8"	233	None
Dakota		1185	1260		None	None
Topeka		3995	4018		None	None
Heebner		4114	4124		None	None
Toronto		4128	4135		None	None
Lansing		4141	4153		None	None
Morrow		4868	4950		None	None
Mississippian		4972	5030		None	None

Describe in detail the manner in which the well was plugged, indicating where the mud fluid was placed and the method or methods used in introducing it into the hole. If cement or other plugs were used, state the character of same and depth placed, from    feet to    feet for each plug set.

Open ended drill pipe was lowered into the well bore to a depth of 500 feet. Twenty sacks of Atlas portland cement were mixed by Halliburton Oil Well Cementing Company and pumped through the drill pipe and covered the interval from 440 to 500 feet. The drill pipe was then pulled so that the bottom of the pipe was at 330 feet. Another 20 sacks of Atlas portland cement was mixed and pumped to cover the interval from 230 to 330 feet. A wood plug was pushed to 10 feet and 10 sacks of Atlas portland cement were mixed and pumped from 0 to 10 feet depth. The surface pipe was then cut off below plow depth and a steel plate was welded over the surface pipe.

Heavy mud was in the hole at the following depths: 5030 to 500 feet.  
440 to 330 feet.  
230 to 10 feet.

RECEIVED  
STATE CORPORATION COMMISSION  
07-13-1959

(If additional description is necessary, use BACK of this sheet)

Name of Plugging Contractor Halliburton Oil Well Cementing Company  
Address Hill City, Kansas

STATE OF Texas, COUNTY OF Taylor, ss.  
I, F. A. Hunter (employee of owner) or ~~(owner or operator)~~ of the above-described well, being first duly sworn on oath, says: That I have knowledge of the facts, statements, and matters herein contained and the log of the above-described well as filed and that the same are true and correct. So help me God.

(Signature) F. A. Hunter  
107 Oil & Gas Bldg., Abilene, Texas  
(Address)

SUBSCRIBED AND SWORN TO before me this 9th day of July, 1959

Martha Shickel  
Notary Public.

My commission expires June 1, 1961

PLUGGING  
FILE SEC. 15 T. 12 R. 39 W  
BOOK PAGE 50 LINE 30

15-199-00009-00-00

CERTIFIED DRILLER'S LOG FOR GENERAL CRUDE OIL COMPANY'S  
No. 1 Delia F. Adams Well NE/4 NE/4 Sec. 15, T 12-S, R 39-W  
Wallace County, Kansas

<u>Depth</u>	<u>Lithology</u>
0- 75	Sand
75-1940	Shale
1940-2150	Shale & shells
2150-2215	Shale & lime
2215-2490	Shale & shells
2490-2780	Shale & sand streaks
2780-2818	Shale, red bed & shells
2818-2850	Anhydrite
2850-2905	Shale & shells
2905-3060	Shale & lime
3060-3208	Red bed
3208-4240	Shale & lime
4240-4275	Lime
4275-4320	Lime & shale
4320-4910	Lime
4910-4945	Lime & shale
4945-5020	Lime
5020-5030	Lime & shale

A F F I D A V I T

STATE OF Texas, COUNTY OF Taylor, SS,

I, F. A. Hunter of the General Crude Oil Company, being first duly sworn on oath, state: That I have knowledge of the facts, statements, and matters herein contained and that the same are true and correct.

F. A. Hunter

Subscribed and sworn to before me this 9th day of July, 1959.

My Commission Expires:

June 1, 1961

Martha Strickert  
Notary Public

STATE OF KANSAS  
JUL 13 1959  
CONSERVATION DIVISION  
Wichita, Kansas

PLUGGING  
FILE SEC. 15 T. 12 R. 39 W  
BOOK PAGE 50 LINE 30