


Give All Information Completely
Make Required Affidavit
Mail or Deliver Report to:
Conservation Division
State Corporation Commission
211 No. Broadway
Wichita, Kansas

15-109-00018-00-00
WELL PLUGGING RECORD

NORTH

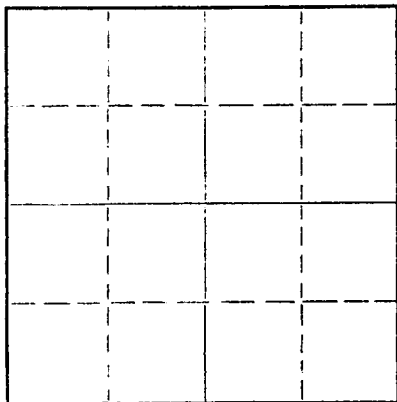

Locate well correctly on above
Section Plat

Logan County. Sec. 12 Twp. 12S Rge. 37 (X) (W)
Location as "NE/CNW/SW" or footage from lines C NW SW
Lease Owner McCliff Oil Co. / Sierra Petro. - Contr.
Lease Name LUTHER Well No. 1
Office Address 325 Atco Bldg. Tulsa, Okla / 420 W. Douglas Ave., Wichita
Character of Well (completed as Oil, Gas or Dry Hole) dry
Date well completed 2/20/57 19
Application for plugging filed 2/19/57 19
Application for plugging approved 2/19/57 19
Plugging commenced 2/20/57 19
Plugging completed 2/20/57 19
Reason for abandonment of well or producing formation dry

If a producing well is abandoned, date of last production 19
Was permission obtained from the Conservation Division or its agents before plugging was commenced? yes

Name of Conservation Agent who supervised plugging of this well Eldon Petty
Producing formation _____ Depth to top _____ Bottom _____ Total Depth of Well 4870 Feet
Show depth and thickness of all water, oil and gas formations.

OIL, GAS OR WATER RECORDS

CASING RECORD

FORMATION	CONTENT	FROM	TO	SIZE	PUT IN	PULLED OUT
				13 3/8	154	none

Describe in detail the manner in which the well was plugged, indicating where the mud fluid was placed and the method or methods used in introducing it into the hole. If cement or other plugs were used, state the character of same and depth placed, from _____ feet to _____ feet for each plug set.

PLUGGING RECORD

Filled hole with heavy mud to 150' set wood plug. 1 sack hulls and 30 sacks cement through drill pipe up to 120'. Filled hole with mud up to 30'. Set wood plug. 1 sack hulls and 20 sacks cement to cellar 0. Job completed 9:30 a.m. 2/20/57

(If additional description is necessary, use BACK of this sheet)
Name of Plugging Contractor Sierra Petroleum Co., Inc.
Address Box 232, Russell, Kansas

STATE OF KANSAS, COUNTY OF RUSSELL, ss.
C. T. Honaker (employee of owner) or (owner or operator) of the above-described well, being first duly sworn on oath, says: That I have knowledge of the facts, statements, and matters herein contained and the log of the above-described well as filed and that the same are true and correct. So help me God.

(Signature) C. T. Honaker
(Address) _____

SUBSCRIBED AND SWORN TO before me this 21st day of February, 19 57.

My commission expires 1-30-61
Margie Cooper Notary Public.

PLUGGING
FILE SEC. 12 T. 12 R. 37w
BOOK PAGE 142 41



02-23-1957

