


STATE OF KANSAS
STATE CORPORATION COMMISSION

WELL PLUGGING RECORD

Give All Information Completely
Make Required Affidavit
Mail or Deliver Report to:
Conservation Division
State Corporation Commission
211 No. Broadway
Wichita, Kansas

Kingman County. Sec. 36 Twp. 29S Rge. 7 (E) 7 (W)
Location as "NE/CNW%SW%" or footage from lines C - NE - NW
Lease Owner Wilcox Oil Company
Lease Name Barney DeWeese Well No. 1
Office Address Box 1440, Tulsa, Okla.
Character of Well (completed as Oil, Gas or Dry Hole) Dry
Date well completed February 9, 1956 19
Application for plugging filed February 10, 1956 19
Application for plugging approved February 13, 1956 19
Plugging commenced February 10, 1956 19
Plugging completed February 12, 1956 19
Reason for abandonment of well or producing formation Dry hole

NORTH

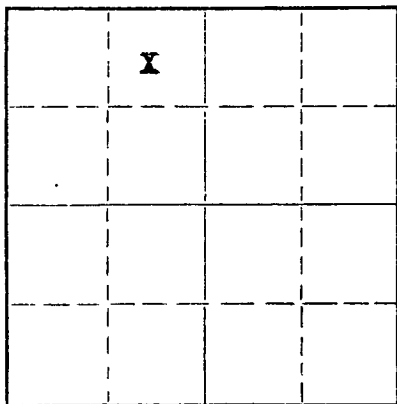

Locate well correctly on above
Section Plat

If a producing well is abandoned, date of last production _____ 19____
Was permission obtained from the Conservation Division or its agents before plugging was commenced? Yes

Name of Conservation Agent who supervised plugging of this well M. A. Rives
Producing formation _____ Depth to top _____ Bottom _____ Total Depth of Well 4245 Feet
Show depth and thickness of all water, oil and gas formations.

OIL, GAS OR WATER RECORDS

CASING RECORD

FORMATION	CONTENT	FROM	TO	SIZE	PUT IN	PULLED OUT
				8-5/8	177'	None

Describe in detail the manner in which the well was plugged, indicating where the mud fluid was placed and the method or methods used in introducing it into the hole. If cement or other plugs were used, state the character of same and depth placed, from _____ feet to _____ feet for each plug set.

Hole filled with rotary mud and plugged in accordance with the rules and regulations of the Kansas Corporation Commission, as supervised by M. A. Rives, Commission field agent.

(If additional description is necessary, use BACK of this sheet)

Name of Plugging Contractor _____
Address _____

STATE OF Tulsa COUNTY OF Oklahoma, ss.
I, William R. Gall (employee of owner) or (owner or operator) of the above-described well, being first duly sworn on oath, says: That I have knowledge of the facts, statements, and matters herein contained and the log of the above-described well as filed and that the same are true and correct. So help me God.

(Signature) William R. Gall
Box 1440 - Tulsa, Oklahoma.
(Address)

SUBSCRIBED AND SWORN TO before me this 16th day of February, 19 56

My commission expires 1-8-59

Kate Dickson
Notary Public.

PLUGGING
FILE SEC 36 T 29 R 7W
BOOK PAGE 38 LINE 11

RECEIVED
COMMISSION
02-20-56