


Give All Information Completely
Make Required Affidavit
Mail or Deliver Report to:
Conservation Division
State Corporation Commission
211 No. Broadway
Wichita, Kansas

WELL PLUGGING RECORD

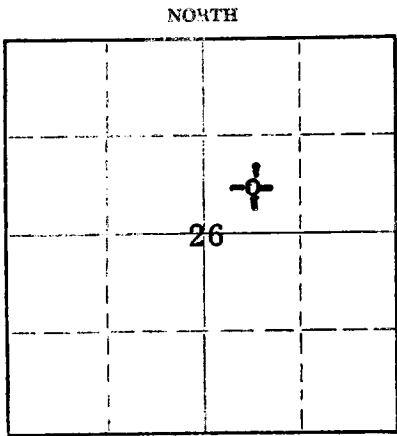

Locate well correctly on above Section Plat

Logan County. Sec. 26 Twp. 12S Rge. 36W ~~2E~~ (W)
Location as "NE/CNW/SW" or footage from lines C SW NE
Lease Owner D. R. Lauck Oil Company, Inc.
Lease Name Keller Well No. 1
Office Address 301 S. Broadway, Wichita, Kansas
Character of Well (completed as Oil, Gas or Dry Hole) Dry Hole
Date well completed October 14, 19 65
Application for plugging filed October 14, 19 65
Application for plugging approved October 14, 19 65
Plugging commenced October 14, 19 65
Plugging completed October 14, 19 65
Reason for abandonment of well or producing formation Dry Hole

If a producing well is abandoned, date of last production _____ 19____
Was permission obtained from the Conservation Division or its agents before plugging was commenced? Yes

Name of Conservation Agent who supervised plugging of this well W. L. Nichols
Producing formation _____ Depth to top _____ Bottom _____ Total Depth of Well 4799 Feet
Show depth and thickness of all water, oil and gas formations.

OIL, GAS OR WATER RECORDS

CASING RECORD

FORMATION	CONTENT	FROM	TO	SIZE	PUT IN	PULLED OUT
		0'	222'	8-5/8"	222'	None

Describe in detail the manner in which the well was plugged, indicating where the mud fluid was placed and the method or methods used in introducing it into the hole. If cement or other plugs were used, state the character of same and depth placed, from _____ feet to _____ feet for each plug set.

Hole filled with Mud 4799-660
Plug 660-656
20 sacks Cement 656-210
Plug 210-206
20 sacks Cement 206- 40
Plug 40- 36
10 sacks Cement 36- 6 Bottom of Cellar.

10-29-1965

(If additional description is necessary, use BACK of this sheet)
Name of Plugging Contractor Lauck Drilling Company, Incorporated
Address 301 S. Broadway, Wichita, Kansas

STATE OF KANSAS, COUNTY OF SEDGWICK, ss.
John H. Knightley (employee of owner) or (owner or operator) of the above-described

well, being first duly sworn on oath, says: That I have knowledge of the facts, statements, and matters herein contained and the log of the above-described well as filed and that the same are true and correct. So help me God.

(Signature) John H. Knightley
301 S. Broadway, Wichita, Kansas
(Address)

SUBSCRIBED AND SWORN TO before me this 28th day of October, 19 65

My commission expires March 12, 1967

Stella J. Lipsa
Notary Public.

15-109-30051-20-00

D. R. Lauck Oil Company, Inc.

Keller #1

C SW NE Sec. 26-12S-36W
Logan County, Kansas

Commenced: October 2, 1965
Completed: October 14, 1965

Casing Record: 222' 8-5/8" Cemented with 165 sacks Cement,
3 sacks Calcium Chloride.

Elevation: GL 3145; DF 3148; KB 3150.

Drillers Log

Tops

Surface Clay	30			
Blue Shale	222			
Shale & Shells	935		Samples	Welex
Shale	1140	Anhydrite		2550+600
Sand	1453	Heebner	3927-777	3926-776
Sand & Shale	1615	Toronto	3945-795	3950-800
Sand	1700	Lansing	3970-820	3970-820
Shale & Shells	1750	Base Kansas City	4312-1162	4310-1160
Sand & Shale, Red Bed	2100	Marmaton		4324-1174
Red Bed & Shells	2215	Cherokee	4475-1325	4472-1322
Anhydrite & Red Bed	2465	Morrow Shale	4642-1492	4642-1492
Shale & Lime	2709	Morrow Sand	4653-1503	4660-1510
Shale & Lime, Red Bed	2871	Reworked Miss.	4698-1548	4696-1546
Shale & Lime	2995	Solid Mississippian		
Lime & Shale	3335	(Ste. Genevieve)	4714-1564	4714-1564
Lime	3460	St. Louis?	4748-1598	4749-1599
Lime & Shale	3575	Total Depth	4799-1649	4798-1648
Lime, Broken	3807			
Lime & Shale	3895			
Lime	4799 RTD			

D&A

I hereby certify that this is a true and correct log of the above mentioned well, to the best of my knowledge and belief.

John W. Knightley

Subscribed and sworn to before me this 28th day of October, 1965.

Stella J. Lipp
Notary Public

My commission expires 3-12-67.

10-29-1965
OCT 28 1965