

STATE OF KANSAS
STATE CORPORATION COMMISSION

WELL PLUGGING RECORD

Give All Information Completely
Make Required Affidavit
Mail or Deliver Report to
Conservation Division
State Corporation Comm.
245 North Water
Wichita, KS 67202

Russell County, Sec. 30 Twp. 11 Rge. 12W E/W
Location as "NE/CNW/SW" or footage from lines
NW SE NE


Lease Owner Shields Oil Producers, Inc.
Lease Name Johnson Well No. 2
Office Address Shields Bldg., Russell, Kansas 67665
Character of Well (Completed as Oil, Gas or Dry Hole)
Dry hole

Date Well completed 10-17 1983
Application for plugging filed 10-17 1983
Application for plugging approved 10-17 1983
Plugging commenced 10-17 1983
Plugging completed 10-17 1983
Reason for abandonment of well or producing formation
Dry hole

If a producing well is abandoned, date of last production
19

Was permission obtained from the Conservation Division or
its agents before plugging was commenced? Yes

Name of Conservation Agent who supervised plugging of this well Gilbert Scheck
Producing formation _____ Depth to top _____ Bottom _____ Total Depth of Well 1,135
Show depth and thickness of all water, oil and gas formations.

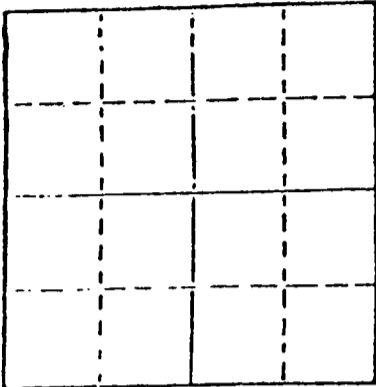

Locate well correctly on above
Section Plot

OIL, GAS OR WATER RECORDS

CASING RECORD

FORMATION	CONTENT	FROM	TO	SIZE	PUT IN	PULLED OUT
				8 5/8"	501'	Cmtd. w/250 sax

Describe in detail the manner in which the well was plugged, indicating where the mud fluid
was placed and the method or methods used in introducing it into the hold. If cement or other
plugs were used, state the character of same and depth placed, from _____ feet to
_____ feet for each plug set.

Fill hole w/heavy mud
Push bridge plug to 770'
Spot 25 sax cement on plug thru 4 1/2" drill pipe
Fill hole w/heavy mud
Push bridge plug to 550'
Spot 100 sax cement on plug thru 4 1/2" drill pipe
Push bridge plug to 40' w/ 1/2 sax hulls on plug
Dump 10 sax cement on plug to cellar
Dump 10 sax cement in rat hole and 10 sax cement in mouse hole

RECEIVED
STATE CORPORATION COMMISSION
10-28-83
OCT 28 1983
CONSERVATION DIVISION
Wichita, Kansas

(If additional description is necessary, use BACK of this sheet)

Name of Plugging Contractor Shields Drilling Co., Inc.

STATE OF KANSAS COUNTY OF RUSSELL, ss.
R.L. SHIELDS (employee of owner) or (owner or operator)
of the above-described well, being first duly sworn on oath, says: That I have knowledge of
the facts, statements, and matters herein contained and the log of the above-described well
as filed and that the same are true and correct. So help me God.

(Signature) R.L. Shields
Shields Bldg., Russell, Kansas

(Address)

SUBSCRIBED AND SWORN TO before me this 26th day of October, 1983

Rush Phillips
Notary Public.

My commission expires

