

STATE OF KANSAS  
STATE CORPORATION COMMISSION


WELL PLUGGING RECORD

Give All Information Completely  
Make Required Affidavit  
Mail or Deliver Report to:  
Conservation Division  
State Corporation Commission  
500 Bittling Building  
Wichita, Kansas

OR  
FORMATION PLUGGING RECORD

Strike out upper line  
when reporting plug-  
ging off formations.

NORTH

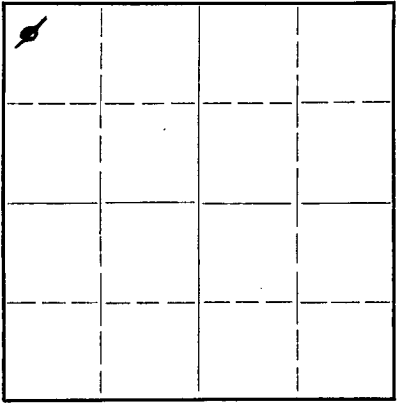

Locate well correctly on above  
Section Plat

Saline County. Sec. 20 Twp. 13 Rge. (E) 1 (W) 1  
Location as "NE 1/4 NW 1/4 SW 1/4" or footage from lines C. NW. NW. NW.  
Lease Owner The Bay Petroleum Corporation  
Lease Name Rockhold Well No. 1  
Office Address 1006 Brown Bldg., Wichita, Kansas  
Character of Well (completed as Oil, Gas or Dry Hole) Dry Hole  
Date well completed January 24 19 43  
Application for plugging filed February 9 19 43  
Application for plugging approved February 2 19 43  
Plugging commenced January 29 19 43  
Plugging completed January 29 19 43  
Reason for abandonment of well or producing formation Dry

If a producing well is abandoned, date of last production 19  
Was permission obtained from the Conservation Division or its agents before plugging was com-  
menced? Yes

Name of Conservation Agent who supervised plugging of this well Ruel Durkee  
Producing formation None Depth to top Bottom Total Depth of Well 3267 Feet  
Show depth and thickness of all water, oil and gas formations.

OIL, GAS OR WATER RECORDS CASING RECORD

Formation	Content	From	To	Size	Put In	Pulled Out
				8-5/8" OD	236'	None

Describe in detail the manner in which the well was plugged, indicating where the mud fluid was placed and the method or methods used in introducing it into the hold. If cement or other plugs were used, state the character of same and depth placed, from feet to feet for each plug set.

Circulate heavy mud 3267' to near  
bottom of surface casing. Halliburton  
spotted 50 sacks cement at bottom and  
15 sacks at top of surface casing.

20 13 1W  
63 7 02-10-1943

(If additional description is necessary, use BACK of this sheet)  
Correspondence regarding this well should be addressed to The Bay Petroleum Corporation  
Address 1006 Brown Bldg.  
Wichita, Kansas

STATE OF Kansas, COUNTY OF Sedgwick, ss.  
J. P. Hemphill (employee of owner) or (owner or operator) of the above-described well,  
being first duly sworn on oath, says: That I have knowledge of the facts, statements, and matters herein contained and the log of the above-  
described well as filed and that the same are true and correct. So help me God.

(Signature) *J. P. Hemphill*  
1006 Brown Bldg., Wichita, Kansas  
(Address)

SUBSCRIBED AND SWORN TO before me this 9th day of February, 19 43

My commission expires Nov. 2, 1946

*Mary Hinzler*  
Notary Public.

15-169-0073D-00-00


BPC 321-Y

BAY PETRO. CORP.  
 Rockhold No. 1.

SEC. 20 T. 13 R. 1 W  
 NWc NW

Total Depth. 3267'  
 Comm. 12-19-42 Comp. 1-24-43  
 Shot or Treated.  
 Contractor.  
 Issued. 2-6-43

County. Saline

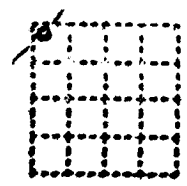

CASING:

8 5/8" 236'

Elevation.

Production. Dry

Figures Indicate Bottom of Formations.

sand & clay	80	Tops:
shale & shells	158	Lansing 1820
red rock	179	Miss. 2473
shale & shells	205	Hunton 2833
shale	236	Viola 3055
anhydrite	245	Simpson shale 3171
lime chalky	395	Simpson sand 3208
red bed	410	Arbuckle 3242
lime	467	
shale	477	
lime sdy & shale strks	508	
shale & lime strks	592	
lime	621	
shale	637	
red rock	670	
lime	690	
shale & lime	943	
shale & shells	1148	
lime & shale	1188	
shale & lime strks	1386	
shale	1392	
lime	1428	
shale & lime	1585	
lime	1685	
shale	1725	
shale & lime	1743	
shale & lime strks	1813	
shale	1821	
lime	1875	
lime & shale	2051	
lime	2156	
shale & lime strks	2264	
shale & lime	2330	
shale & shells	2385	
shale	2446	
lime	2474	
chat	2585	
chat & lime	2635	
chatty lime	2665	
lime & shale	2718	
shale	2790	
shale & lime	2824	
lime	2915	
lime & shale strks	2970	
shale	3003	
lime & shale	3034	
shale	3056	
lime	3208	
sand	3219	
shale & sand strks	3231	
lime	3267	
Total Depth.		

02-10-1943

20 13 1W  
 63 7