


15-169-20249-00-00

STATE OF KANSAS
STATE CORPORATION COMMISSION

WELL PLUGGING RECORD

Give All Information Completely
Make Required Affidavit
Mail or Deliver Report to
Conservation Division
State Corporation Comm.
245 North Water
Wichita, KS 67202

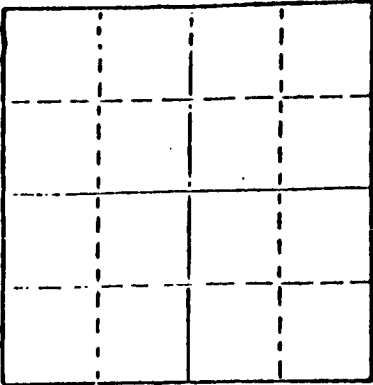

Saline County. Sec. 29 Twp. 13 Rge. 1W E/W
Location as "NE/CNW1SW1" or footage from lines
SW NE
Lease Owner Mack Energy Company
Lease Name Mattison Well No. 1
Office Address Box 400, Duncan, Oklahoma 73534
Character of Well (Completed as Oil, Gas or Dry Hole)

Date Well completed 6/16 1984
Application for plugging filed 6/16 1984
Application for plugging approved 6/16 1984
Plugging commenced 6/16 1984
Plugging completed 6/16 1984
Reason for abandonment of well or producing formation

If a producing well is abandoned, date of last production 19

Was permission obtained from the Conservation Division or its agents before plugging was commenced? Yes

Name of Conservation Agent who supervised plugging of this well Merlan Unruh
Producing formation Depth to top Bottom Total Depth of Well 3335'
Show depth and thickness of all water, oil and gas formations.

OIL, GAS OR WATER RECORDS

CASING RECORD

FORMATION	CONTENT	FROM	TO	SIZE	PUT IN	PULLED OUT
	Surface	0	208.85	8 5/8"	208.85	0

Describe in detail the manner in which the well was plugged, indicating where the mud fluid was placed and the method or methods used in introducing it into the hold. If cement or other plugs were used, state the character of same and depth placed, from feet to feet for each plug set.

50 sacks cement @ 300'
20 sacks cement @ 60'
10 sacks cement in rathole

(If additional description is necessary, use BACK of this sheet)

Name of Plugging Contractor EDCO Drilling Company, Inc.

STATE OF Kansas COUNTY OF Butler, ss.
(employee of owner) or (owner or operator)
of the above-described well, being first duly sworn on oath, says: That I have knowledge of the facts, statements, and matters herein contained and the log of the above-described well as filed and that the same are true and correct. So help me God.

(Signature) W. B. [Signature]
Box 645, El Dorado, Kansas 67042
(Address)

SUBSCRIBED AND SWORN TO before me this 18th day of June, 1984

TERESA E. ORR
NOTARY PUBLIC
STATE OF KANSAS
My commission expires
MY APPT. EXP. 10-13-86


[Signature]
Notary Public.

RECEIVED
STATE CORPORATION COMMISSION
JUN 20 1984
CONSERVATION DIVISION
Wichita, Kansas

15-169-20249-00-00



DRILLING COMPANY, INC.

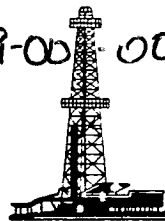

114 WEST LOCUST — P.O. BOX 645 — EL DORADO, KANSAS 67042

June 18, 1984

To: Mack Energy Company
Box 400
Duncan, Oklahoma 73534

Lease: Mattison #1

Location: Sec. 29, Twp. 13, Rge. 1W
Saline County

Drilling
Dates: June 11 thru June 16, 1984

Drilling Log

Surface T.D. 218'
Surface Set 208.85' of 8 5/8" Surface Casing
Cemented by Halliburton

0 - 180'	Open Hole
180 - 220'	Cement
220 - 1281'	Shale w/Lime Streaks
1281 - 1410'	Shale & Sand Mixed
1410 - 1852'	Shale w/Lime Streaks
1852 - 2104'	Lime w/Shale Streaks
2104 - 2484'	Shale & Lime mixed
2484 - 2590'	Shale w/Lime Streaks
2590 - 2735'	Mississippi
2735 - 2835'	Kinderhook
2835 - 2890'	Lime & Shale Mixed
2890 - 3150'	Hunton
3150 - 3265'	Viola
3265 - 3335'	Simpson
3335'	T.D.

RECEIVED
STATE CORPORATION COMMISSION
06-20-1984
JUN 20 1984
CONSERVATION DIVISION
Wichita, Kansas