


15-169-00235-00-00

Give All Information Completely  
Make Required Affidavit  
Mail or Deliver Report to:  
Conservation Division  
State Corporation Commission  
211 No. Broadway  
Wichita, Kansas

WELL PLUGGING RECORD

NORTH

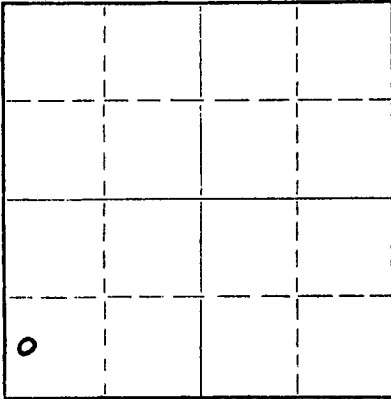

Locate well correctly on above  
Section Plat

Saline County. Sec. 36 Twp. 13 Rge. 1 (E) 1 (W)  
Location as "NE/CNW/SW" or footage from lines W/2 SW SW  
Lease Owner Hollar Oil Co.  
Lease Name Enright Well No. 1  
Office Address 1117 Wichita Plaza, Wichita, Kansas  
Character of Well (completed as Oil, Gas or Dry Hole) Dry Hole  
Date well completed 12/5 12/5/ 19 64  
Application for plugging filed 12/5 19 64  
Application for plugging approved 12/5 19 64  
Plugging commenced 12/5 19 64  
Plugging completed 12/5 19 64  
Reason for abandonment of well or producing formation Dry Hole

If a producing well is abandoned, date of last production \_\_\_\_\_ 19\_\_\_\_  
Was permission obtained from the Conservation Division or its agents before plugging was commenced? yes

Name of Conservation Agent who supervised plugging of this well Gilbert Toman  
Producing formation \_\_\_\_\_ Depth to top \_\_\_\_\_ Bottom \_\_\_\_\_ Total Depth of Well 2455 Feet  
Show depth and thickness of all water, oil and gas formations.

OIL, GAS OR WATER RECORDS

CASING RECORD

FORMATION	CONTENT	FROM	TO	SIZE	PUT IN	PULLED OUT
				8 5/8	120'	none

Describe in detail the manner in which the well was plugged, indicating where the mud fluid was placed and the method or methods used in introducing it into the hole. If cement or other plugs were used, state the character of same and depth placed, from \_\_\_\_\_ feet to \_\_\_\_\_ feet for each plug set.

heavy mud 2455' to 115'  
wooden plug 115'  
20 sx cement on plug  
heavy mud to 40'  
wooden plug 40'  
10 sx cement on plug  
surface soil 5' to 0'

RECEIVED  
STATE CORPORATION COMMISSION  
DEC 10 1964  
12-10-1964  
CONSERVATION DIVISION  
Wichita, Kansas

(If additional description is necessary, use BACK of this sheet)

Name of Plugging Contractor Melland Drilling Co., Inc.  
Address Box 783, McPherson, Kansas

STATE OF Kansas, COUNTY OF McPherson, ss.  
Donald J. Melland (employee of owner) or (owner or operator) of the above-described well, being first duly sworn on oath, says: That I have knowledge of the facts, statements, and matters herein contained and the log of the above-described well as filed and that the same are true and correct. So help me God.

(Signature) Donald J. Melland  
Box 783, McPherson, Kansas  
(Address)

SUBSCRIBED AND SWORN TO before me this 7th day of December, 19 64

My commission expires December 23, 1964

Notary Public.

# WELL RECORD

LEASE: Enright

WELL NO. 1

ELEVATION: 1173 RB

LOCATION: W/2 SW SW  
Sec. 36-13-1W

COMMENCED: 11/30/64

COMPLETED: 12/5/64

OPERATOR: Hollar Oil Co.

CONTRACTOR: Melland Drilling Company, Inc.  
Post Office Box 783  
McPherson, Kansas

CASING RECORD: 8 5/8" @ 120'/90sx

FORMATION	LOG
clay	30
sand	65
shale & shells	90
anhydrite	120
lime	225
lime & shale	600
shale & shells	1470
lime & shale	1636
shale & sand	1786
lime & shale	2108
shale	2443
Mississippi	2455
RTD	2455
Sample Tops	
Lansing	1782
Mississippian	2428

FORMATION LOG

RECEIVED  
STATE CORPORATION COMMISSION


DEC 10 1964  
12-10-1964  
CONSERVATION DIVISION  
Wichita, Kansas

## CERTIFICATE

State of Kansas, County of McPherson, ss.

I, Donald J. Melland, do hereby certify that the above is a true and correct copy of the log of the above named and described well, as reflected by the records of the Melland Drilling Company, Inc.

Donald J. Melland

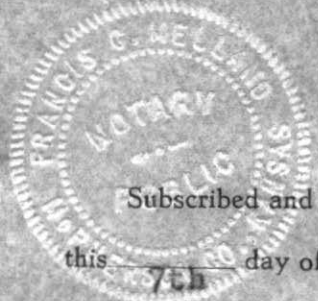

Subscribed and sworn to before me, a Notary Public, in and for the County of McPherson, State of Kansas,

this 7th day of December, 1964

Francis G. Melland  
Notary Public

My Commission expires: December 23, 1967