


WELL PLUGGING RECORD

Give All Information Completely  
Make Required Affidavit  
Mail or Deliver Report to:  
Conservation Division  
State Corporation Commission  
211 No. Broadway  
Wichita, Kansas

NORTH

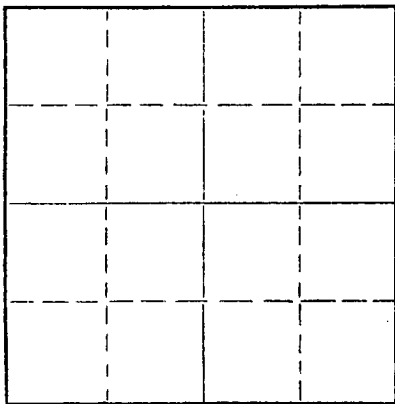

Locate well correctly on above  
Section Plat

Saline County. Sec. 34 Twp. 13S Rge. 2 (E) 2 (W)  
Location as "NE/CNWSW" or footage from lines 2310' FN & EL  
Lease Owner Kewanee Oil Company  
Lease Name Cambria Well No. 1  
Office Address Box 360, Hoisington, Kansas  
Character of Well (completed as Oil, Gas or Dry Hole) Dry Hole  
Date well completed May 22, 19 60  
Application for plugging filed May 22, 19 60  
Application for plugging approved Verbal May 22, 19 60  
Plugging commenced May 22, 19 60  
Plugging completed May 22, 19 60  
Reason for abandonment of well or producing formation Dry hole.

If a producing well is abandoned, date of last production 19  
Was permission obtained from the Conservation Division or its agents before plugging was commenced? Yes

Name of Conservation Agent who supervised plugging of this well Mr. Gilbert P. Toman, Box 180, Holyrood, Kansas  
Producing formation \_\_\_\_\_ Depth to top \_\_\_\_\_ Bottom \_\_\_\_\_ Total Depth of Well 3600 Feet  
Show depth and thickness of all water, oil and gas formations.

OIL, GAS OR WATER RECORDS

CASING RECORD

FORMATION	CONTENT	FROM	TO	SIZE	PUT IN	PULLED OUT
Mississippi	Dry	2615		8-5/8	234	None
Viola	Dry	3160				
Simpson	Dry	3278				
Arbuckle	Dry	3343				

Describe in detail the manner in which the well was plugged, indicating where the mud fluid was placed and the method or methods used in introducing it into the hole. If cement or other plugs were used, state the character of same and depth placed, from \_\_\_\_\_ feet to \_\_\_\_\_ feet for each plug set.

Filled hole with mud to 220'.  
Set HOWCO plug at 220' with 1/4 sack hulls.  
Dumped 20 sacks cement through drill pipe.  
Mudded to 40' and set HOWCO plug at 40'.  
Dumped 1/4 sack hulls on top of plug.  
Filled to bottom of cellar with cement.  
Plugged and abandoned at 9:30 A.M.

(If additional description is necessary, use BACK of this sheet)

Name of Plugging Contractor White & Ellis Drilling Company, Inc.  
Address Box 448, Eldorado, Kansas

STATE OF Kansas, COUNTY OF Barton, ss.  
Peter Blanda (employee of owner) or (owner or operator) of the above-described

well, being first duly sworn on oath, says: That I have knowledge of the facts, statements, and matters herein contained and the log of the above-described well as filed and that the same are true and correct. So help me God.

(Signature) Peter Blanda

Box 360, Hoisington, Kansas  
(Address)

SUBSCRIBED AND SWORN TO before me this 24th day of May, 19 60

My commission expires September 21, 1961

[Signature]  
Notary Public.

MAY 31 1960  
05-31-1960  
CON. DIVISION  
Wichita, Kansas

## KEWANEE OIL COMPANY

West Kansas District

Wildcat

Well Record and Sandology: Cambria No. 1.

Location: 2310' FW & EL Section 34, T-13-S, R-2-W,  
Saline County, Kansas.Elevation: 1200' Cement Marker (C.M. 1.50' above top  
of 8-5/8" casing).

Drilling Commenced: May 10, 1960.

Drilling Completed: May 21, 1960.

Completion Date: May 22, 1960.

Total Depth: 3600' C.M.

Perforation Record: None.

Treating Record: None.

Initial Production: Dry hole.

FORMATION TOPS

	<u>Sample Tops</u>	<u>Log Tops</u>
Lansing	2082 - 882	2088 - 888
Base K.C.	2424 -1224	2422 -1222
Mississippi	2616 -1416	2615 -1415
Kinderhook	2810 -1610	2792 -1592
Misner	2942 -1742	2942 -1742
Hunton	2958 -1758	2952 -1752
Maquoketa	3064 -1864	3056 -1856
Viola	3160 -1960	3160 -1960
Simpson	3280 -2080	3278 -2078
Arbuckle	3348 -2148	3343 -2143
Granite Wash	3588 -2388	3580 -2380

Casing Record

Ran 234' of 8-5/8" casing and set at 968.36' C.M.  
Cemented with 175 sacks pozmix with 1/4" floccle  
per sack and 2% Calcium Chloride. Cement did not  
circulate. Ran 1" to top of cement at 104' and  
cemented to surface with 100 sacks regular cement.

Formation Record

0 - 115	Sand, clay & shale.
115 - 236	Lime & shale.
236 - 665	Lime, sand & shale.
665 - 780	Shale & red rock.
780 - 1445	Shale, lime & shells.
1445 - 1650	Lime with shale streaks.
1650 - 1862	Lime, shale & shells.
1862 - 1929	Shale & sand.
1929 - 2102	Lime.
2102 - 2274	Lime & Shale.
2274 - 2425	Shale & lime.
2425 - 2616	Shale.
2616 - 2810	Lime.
2810 - 2958	Shale & sand.
2958 - 3063	Lime.
3063 - 3160	Lime & shale.
3160 - 3280	Lime.
3280 - 3348	Shale & sand.
3348 - 3588	Lime.
3588 - 3600	Granite Wash - Total Depth.