

STATE OF KANSAS
 STATE CORPORATION COMMISSION
 200 Colorado Derby Bldg.
 Wichita, Kansas 67202


Form CP-4
 Rev. 12-15-80

15-169-20211-00-00

WELL PLUGGING RECORD

Give All Information Completely
 Make Required Affidavit

COUNTY Saline SEC. 17 TWP. 13 RGE. 2W E/W
 Location as in quarters or footage from lines:
1320' FNL & 1320' FEL C NE/4

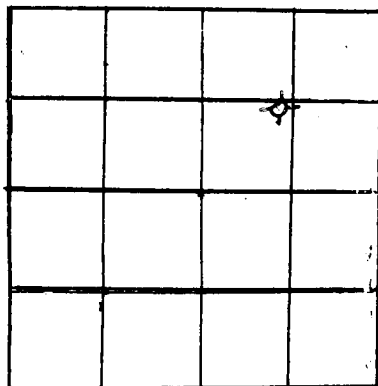

Locate Well
 correctly on above
 Section Platt.

Lease Owner DARMAC PETROLEUM, INC.
 Lease Name NEECES Neises Well No. 1
 Office Address P.O. Box 7013, Waco, Texas 76710
 Character of Well (Completed as Oil, Gas or Dry Hole): Dry Hole
 Date Well Completed 5/13/83
 Application for plugging filed _____
 Plugging commenced _____
 Plugging completed _____
 Reason for abandonment of well or producing formation Dry Hole

Was permission obtained from the Conservation Division or it's
 Agent's before plugging was commenced? Yes

Name of Conservation Agent who supervised plugging of this well Jack Haley
 Producing formation _____ Depth to top _____ bottom T.D.

Show depth and thickness of all water, oil and gas formations.

OIL, GAS OR WATER RECORDS

Casing Record

Formation	Content	From	To	Size	Put in	Pulled Out
Clay		0	45'	8 5/8"	45'	None
Sand		45'	60'	8 5/8"	15'	None
Shale		60'	208'	8 5/8"	148'	None

Describe in detail the manner in which the well was plugged, indicating where the mud
 fluid was placed and the method or methods used in introducing it into the hold. If cement
 or other plugs were used, state the character of same and depth placed, from _____ feet
 to _____ feet for each plug set.

Filled hole with mud to 310' & set plug with 50 sacks of cement. Filled hole
with mud to 40' and set plug with 10 sacks of cement, 10 sacks in rathole.
Plugging completed at 4:30 P. M., May 13, 1983 by State Plugger, Jack Haley.

(If additional description is necessary, use BACK of this sheet)

Name of Plugging Contractor Blackstone Drilling, Inc., P.O. Box 1184, McPherson, Kansas 67460

STATE OF Kansas COUNTY OF Saline, ss.
Darmac Petroleum, Inc. (employee of owner) or (owner or operator) of the
 above-described well, being first duly sworn on oath, says: That I have knowledge of the
 facts, statements, and matters herein contained and the log of the above-described well as
 filed and that the same are true and correct. STATE CORPORATION COMMISSION TO help me God. DARMAC PETROLEUM, INC.

MAY 31 1983
 05-31-1983
 CONSERVATION DIVISION
 Wichita, Kansas

(Signature) BY: Earl J. Fairman
P.O. Box 7013, Waco, Texas 76710
 (Address)

SUBSCRIBED AND SWORN TO before me this 26 day of May, 19 83

Opdelia Coe
 Notary Public.

My Commission expires: 4/22/85