


STATE OF KANSAS
STATE CORPORATION COMMISSION
TERRA RESOURCES
WELL PLUGGING RECORD

15-169-20083-00-00

Give All Information Completely
Make Required Affidavit
Mail or Deliver Report to
Conservation Division
State Corporation Comm.
245 North Water
Wichita, KS 67202

Saline County, Sec. 33 Twp. 13S Rge. 2 X
Location as "NE/CNW $\frac{1}{4}$ SW $\frac{1}{4}$ " or footage from lines
C SW

Lease Owner Terra Resources, Inc.
Lease Name Geis Well No. 1
Office Address P.O. Box 839, Oklahoma City, OK 73101
Character of Well (Completed as Oil, Gas or Dry Hole)

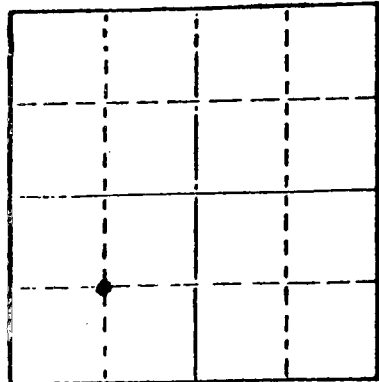

Locate well correctly on above
Section Plot

Dry Hole
Date Well completed 7/6/78
Application for plugging filed 7/6/78
Application for plugging approved 7/6/78
Plugging commenced 7/6/78
Plugging completed 7/6/78
Reason for abandonment of well or producing formation

Dry Hole
If a producing well is abandoned, date of last production

Was permission obtained from the Conservation Division or
its agents before plugging was commenced? Yes

Name of Conservation Agent who supervised plugging of this well Gilbert Toman
Producing formation Depth to top Bottom Total Depth of Well 3429
Show depth and thickness of all water, oil and gas formations.

OIL, GAS OR WATER RECORDS

CASING RECORD

FORMATION	CONTENT	FROM	TO	SIZE	PUT IN	PULLED OUT

Describe in detail the manner in which the well was plugged, indicating where the mud plugs were placed and the method or methods used in introducing it into the hold. If cement or other plugs were used, state the character of same and depth placed, from feet to feet for each plug set.

drilling mud to 330', 25 sx cement, drilling mud to 40', 10 sx 55 poz, 4% gel
2 sx rathole, 2 sx mousehole.

07-26-1978
JUL 26 1978

(If additional description is necessary, use BACK of this sheet)

Name of Plugging Contractor B & N Drilling Company, Division of Benson Mineral Group, Inc.

STATE OF KANSAS COUNTY OF MONTGOMERY, ss. contractor
Lucille Shukers (employee of ~~B&N~~) or ~~(XXXXXXXXXXXXXXXXXXXX)~~
of the above-described well, being first duly sworn on oath, says: That I have knowledge of the facts, statements, and matters herein contained and the log of the above-described well as filed and that the same are true and correct. So help me God.

(Signature) Lucille Shukers
Box 846, Independence, Ks. 67301
(Address)

SUBSCRIBED AND SWORN TO before me this 13th day of July, 1978

My commission expires 9/24/78

Jane McNickle
Notary Public.

JANE McNICKLE
NOTARY
PUBLIC
Montgomery County, Kansas

KANSAS DRILLERS LOG


JUL 17 1978

S. 33 T. 13S. R. 2 W

API No. 15 - 169 - 20083-00-00 RECEIVED
 County Number

Loc. C-SW.
 County Saline

640 Acres
 N

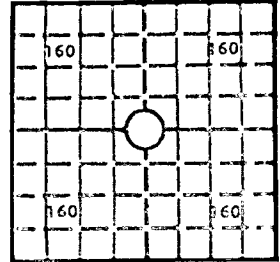

Locate well correctly

Elev.: Gr. 1207

DF 1214 KB 1217

Operator: Terra Resources, Inc.
 Address: P.O. Box 839 Oklahoma City, Oklahoma 73101
 Well No. #1 Lease Name Geis
 Footage Location: 1320 feet from (S) line, 1320 feet from (W) line
 Principal Contractor: B & N Drilling Geologist: Bob Hopkins
 Spud Date: 6-21-78 Total Depth: 3440 P.B.T.D.
 Date Completed: 7-6-78 Oil Purchaser:

CASING RECORD

Report of all strings set — surface, intermediate, production, etc.

Purpose of string	Size hole drilled	Size casing set (in O.D.)	Weight lbs/ft.	Setting depth	Type cement	Sacks	Type and percent additives
Surface	12 1/4	8 5/8	24	354	Poz 50/50 Comm	275 80	3% CC 2% CC
Production							

LINER RECORD

PERFORATION RECORD

Top, ft.	Bottom, ft.	Sacks cement	Shots per ft.	Size & type	Depth interval

Size	Setting depth	Packer set at

ACID, FRACTURE, SHOT, CEMENT SQUEEZE RECORD

Amount and kind of material used	Depth interval treated

JUL 26 1978
 09-26-1978

INITIAL PRODUCTION

Date of first production: _____ Producing method (flowing, pumping, gas lift, etc.): _____

RATE OF PRODUCTION PER 24 HOURS	Oil	Gas	Water	Gas-oil ratio
	bbls.	bbls.	MCF	CFPB

Disposition of gas (vented, used on lease or sold): _____ Producing interval(s): _____

INSTRUCTIONS: As provided in KCC Rule 82-2-125, within 90 days after completion of a well, one completed copy of this Drillers Log shall be transmitted to the State Geological Survey of Kansas, 4150 Monroe Street, Wichita, Kansas 67209. Copies of this form are available from the Conservation Division, State Corporation Commission, 3830 So. Meridian (P.O. Box 17027), Wichita, Kansas 66217. Phone AC 316-522-2206. If confidential custody is desired, please note Rule 82-2-125. Drillers Logs will be on open file in the Oil and Gas Division, State Geological Survey of Kansas, Lawrence, Kansas 66044.

15-169-20083-00-00

DESIGNATE TYPE OF COMP.: OIL, GAS, DRY HOLE, SWDW, ETC.:

Operator

Terra Resources, Inc.

Well No.

#1

Lease Name

Geis

S 33 T 13R 2 ^{EX} W

WELL LOG

SHOW GEOLOGICAL MARKERS, LOGS RUN, OR OTHER DESCRIPTIVE INFORMATION.

Show all important zones of porosity and contents thereof; cored intervals, and all drill-stem tests, including depth interval tested, cushion used, time tool open, flowing and shut-in pressures, and recoveries.

FORMATION DESCRIPTION, CONTENTS, ETC.	TOP	BOTTOM	NAME	DEPTH
Sand/Clay	0	134		
Shale/Lime	134	545		
Lime/Shale	545	2875		
Shale	2875	2970		
Lime/Shale	2970	3440		

USE ADDITIONAL SHEETS, IF NECESSARY, TO COMPLETE WELL RECORD.

Date Received

Signature

Title

Date

Handwritten notes and stamps at the bottom of the page, including a date stamp 'MAY 20 1983'.