


Give All Information Completely  
Make Required Affidavit  
Mail or Deliver Report to:  
Conservation Division  
State Corporation Commission  
211 No. Broadway  
Wichita, Kansas

Saline County, Sec. 31 Twp. 13 Rge. (E) 2 (W)  
Location as "NE/CNW/SW" or footage from lines SW SE  
Lease Owner Donald T. Ingling et al  
Lease Name Morrison Well No. 1  
Office Address 615 First National Bldg., Wichita, Kans  
Character of Well (completed as Oil, Gas or Dry Hole) Dry Hole  
Date well completed August 16, 19 64  
Application for plugging filed August 16, 19 64  
Application for plugging approved August 16, 19 64  
Plugging commenced August 16, 19 64  
Plugging completed August 16, 19 64  
Reason for abandonment of well or producing formation dry

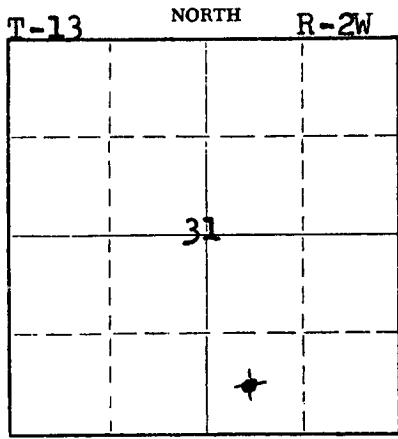

Locate well correctly on above Section Plat

If a producing well is abandoned, date of last production 19  
Was permission obtained from the Conservation Division or its agents before plugging was commenced? Yes

Name of Conservation Agent who supervised plugging of this well Gilbert Toman  
Producing formation \_\_\_\_\_ Depth to top \_\_\_\_\_ Bottom \_\_\_\_\_ Total Depth of Well 3217 Feet  
Show depth and thickness of all water, oil and gas formations.

OIL, GAS OR WATER RECORDS

CASING RECORD

FORMATION	CONTENT	FROM	TO	SIZE	PUT IN	PULLED OUT
				8 5/8"	203'	none

Describe in detail the manner in which the well was plugged, indicating where the mud fluid was placed and the method or methods used in introducing it into the hole. If cement or other plugs were used, state the character of same and depth placed, from \_\_\_\_\_ feet to \_\_\_\_\_ feet for each plug set.

Mud back to 195 feet, a plug, 1/4 sack hulls, 20 sacka cement;  
mud back to 40 feet, plug to hold Kelly, 10 sacks cement and  
2 sacks cement in rat hole

RECEIVED  
STATE CORPORATION COMMISSION

AUG 20 1964  
0820-1964  
CONSERVATION DIVISION  
Wichita, Kansas

(If additional description is necessary, use BACK of this sheet)

Name of Plugging Contractor Donald T. Ingling  
Address 615 First National Bldg., Wichita, Kansas

STATE OF KANSAS, COUNTY OF SEDGWICK, ss.  
D. T. Ingling (of owner) or (owner or operator) of the above-described well, being first duly sworn on oath, says: That I have knowledge of the facts, statements, and matters herein contained and the log of the above-described well as filed and that the same are true and correct. So help me God.

(Signature) *D. T. Ingling*  
615 First National Bldg., Wichita, Kans  
(Address)

SUBSCRIBED AND SWORN TO before me this 18th day of August, 19 64

My commission expires Feb. 27, 1968

*M. E. Beach*  
Notary Public.

WELL LOG - MORRISON NO. 1

15-169-0024-00-00

Donald T. Ingling et al, Lease Owner

Section 31-13-2W

Donald T. Ingling, Contractor

Location: SW SE

Commenced: 8-1-64

County: Saline

Completed: 8-17-64

Production: Dry

Total Depth: 3217'

Elevation: 1214 RB

Casing: 8 5/8" 203' (150 sacks cement)

Figures below indicate bottom formation

35	clay
75	sand
203	shale and shells
500	lime and shale
720	lime and shale streaks
1050	lime and shale
1450	shale and shells
1500	shale and shells
1660	lime
1860	lime and shale
1920	shale
2008	lime
2160	lime
2270	lime
2370	lime
2450	lime
2490	shale and lime streaks
2690	lime and shale
2780	Mississippi
2831	lime
2905	lime
2995	shale
3029	lime and shale
3041	lime
3065	lime
3103	lime
3122	shale
3165	shale
3209	shale
3217	dolomite
3217	Total Depth

I certify this is a true and correct copy of the above mentioned well.

D. T. Ingling

STATE OF KANSAS, SEDGWICK COUNTY: ss

Subscribed and sworn to before me, a Notary Public, in said county and state.

M. E. Beach  
Notary Public

My commission expires: Feb. 27, 1968