

15-167-21840-0000


STATE OF KANSAS
STATE CORPORATION COMMISSION
200 Colorado Derby Bldg.
Wichita, Kansas 67202

Form CP-4
Rev. 12-15-80

WELL PLUGGING RECORD

Give All Information Completely
Make Required Affidavit

COUNTY RUSSELL SEC. 19 TWP. 11S RGE. 15 E/W
Location as in quarters or footage from lines:
1360' FSL, 1700' FEL

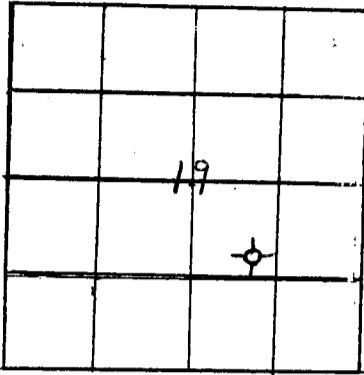

Locate Well
correctly on above
Section Platt.

Lease Owner American Lariat, Inc.
Lease Name VonFeldt Well No. 1
Office Address Box 936, Hays, KS 67601
Character of Well (Completed as Oil, Gas or Dry Hole): Dry
Date Well Completed April 21, 1983
Application for plugging filed April 19, 1983
Plugging commenced April 20, 1983 0800 Hours
Plugging completed April 20, 1983 1050 Hours
Reason for abandonment of well or producing formation Non Commercial

Was permission obtained from the Conservation Division or it's
Agent's before plugging was commenced? Yes

Name of Conservation Agent who supervised plugging of this well Marion Schmidt
Producing formation NIL Depth to top -- bottom -- T.D. 3680.5
Show depth and thickness of all water, oil and gas formations.

OIL, GAS OR WATER RECORDS

Casing Record

Formation	Content	From	To	Size	Put in	Pulled Out
Conglomerate	Water	3340	3525		5 1/2" csg.	NIL
Kansas City	Water	3089	3166		5 1/2" csg.	NIL
Topeka	Water	2794	2803		5 1/2" csg.	NIL
Permian	Water	2186	2189		5 1/2" csg.	NIL

Describe in detail the manner in which the well was plugged, indicating where the mud fluid was placed and the method or methods used in introducing it into the hold. If cement or other plugs were used, state the character of same and depth placed, from 2210 feet to 70 feet for each plug set. Top permanent plug at 2210' in 5 1/2".

Pumped down surface pipe 1/2 sx cottonseed hulls, 100 sx 50-50 Pozmix plus 4% gel and 3% CaCl.
Pumped down 5 1/2" production csg. 10 sx 50-50 Pozmix plus 4% gel and 3% CaCl.
Then 3 sx cottonseed hulls, then 40 sx 50-50 Pozmix (as above). Follow with 6 sx gel, released 5 1/2" wiper plug. Then 125 sx 50-50 Pozmix (as above). Waited 24 hours and tagged cement plug at 70'. Cut off csg and welded on cap.

Well logs sent in with ACO-1 Form.

(If additional description is necessary, use BACK of this sheet)

Name of Plugging Contractor Sun Oilwell Cementers

STATE OF KANSAS COUNTY OF ELLIS, ss.

GERALD MARLEAU (employee of owner) or (owner or operator) of the above-described well, being first duly sworn on oath, says: That I have knowledge of the facts, statements, and matters herein contained and the log of the above-described well as filed and that the same are true and correct. So help me God.



(Signature) [Signature]
Hays, Ks.
(Address)

SUBSCRIBED AND SWORN TO before me this 6th day of May, 1983

Karen H. Marshall
Notary Public.

My Commission expires: 3-4-87

RECEIVED
STATE CORPORATION COMMISSION

MAY 09 1983

CONSERVATION DIVISION
Wichita, Kansas