

STATE OF KANSAS
 STATE CORPORATION COMMISSION
 200 Colorado Derby Building
 Wichita, Kansas 67202

WELL PLUGGING RECORD
 K.A.R.-82-3-117

API NUMBER 15-167-01729-0000

LEASE NAME Whitson

WELL NUMBER 2

TYPE OR PRINT
 NOTICE: Fill out completely
 and return to Cons. Div.
 office within 30 days.

660 Ft. from S Section Line

4,290 Ft. from E Section Line

SEC. 16 TWP. 11 RGE. 15 (X) or (W)

COUNTY Russell

Date Well Completed 3/47

Plugging Commenced 12/26/89

Plugging Completed 12/27/89

LEASE OPERATOR BP Exploration

ADDRESS 9401 SW Fwy, Houston, TX 77074

PHONE (713) 272-5000 OPERATORS LICENSE NO. 06854

Character of Well oil

(Oil, Gas, D&A, SWD, Input, Water Supply Well)

The plugging proposal was approved on 12/20/89 (date)

by Dennis Hammel (KCC District Agent's Name).

Is ACO-1 filed? yes If not, is well log attached? _____

Producing Formation Top-L-KC Depth to Top 2,895 Bottom 3,165 T.D. 3,350

Show depth and thickness of all water, oil and gas formations.

PBTD 3248

OIL, GAS OR WATER RECORDS | CASING RECORD

Formation	Content	From	To	Size	Put In	Pulled out
Topeka	oil(2890-3165)	0	953	8-5/8"	953	6'
Lansing-KC	oil(3165-3260)	0	3338	5 1/2"	3338	6'
Arbuckle	oil(3260-NDE)					

Describe in detail the manner in which the well was plugged, indicating where the mud fluid was placed and the method or methods used in introducing it into the hole. If cement or other plugs were used, state the character of same and depth placed, from feet to feet each set.
 Set EZSV @ 2,845'. Shot two holes @ 975'. Pumped 100 sx w/300# hulls below retainer.
 Dropped 10 sx cement on top. Spotted 10 sx gel to 1,000'. Circulated 75 sx cement from 1,000' to surface. Tied onto 5 1/2" csg. Pumped 125 sx down 5 1/2" and circulated out of perfs. at 975' and up 8-5/8 x 5 1/2" annulus to surface. Cement 65/35 POZ w/8% gel and 2% CaCl.
 (If additional description is necessary, use BACK of this form.)

Name of Plugging Contractor Halliburton License No. 5287

Address 1100 E. 8th, Hays, Kansas 1-17-90


NAME OF PARTY RESPONSIBLE FOR PLUGGING FEES: BP Exploration

STATE OF Texas COUNTY OF Harris, ss.

Scott Marshall (Employee of Operator) or (Operator) of above-described well, being first duly sworn on oath, says: That I have knowledge of the facts, statements, and matters herein contained and the log of the above-described well as filed that the same are true and correct, so help me God.

(Signature) Scott Marshall

(Address) 9401 SW Fwy, Houston, TX 77074

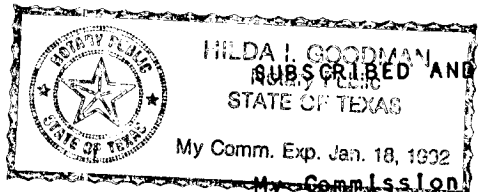

SWORN TO before me this 15th day of January, 19 90
Hilda I. Goodman
 Notary Public

Express: 1-18-92

RUSSELL COUNTY

WHITSON #2

15-167-01729-0000
FAIRPORT

TD: 3350'

PBTD: 3248'

22-141 50 SHEETS
22-142 100 SHEETS
22-144 200 SHEETS



1000'

2000'

RECEIVED
STATE OF KANSAS COMMISSION

15-167-01729

STATE OF KANSAS
Topeka, Kansas

TOPEKA
2899-2904'

3000' LANSING -
KANSAS CITY

ARBUCKLE →
OPEN HOLE
3338-50'

2988-3002'
3170-3174'
3208-3210'

5 1/2" 14ppf @ 3338'
7 7/8" HOLE
175 SX CMT
TOC: 3054'

4000'

SPUD: 1947

TA'D: 1986