

15-167-06302-0000

STATE OF KANSAS
STATE CORPORATION COMMISSION


WELL PLUGGING RECORD

Give All Information Completely
Make Required Affidavit
Mail or Deliver Report to:
Conservation Division
State Corporation Commission
800 Bitting Building
Wichita, Kansas

OR
FORMATION PLUGGING RECORD

Strike out upper line
when reporting plug-
ging off formations.

NORTH

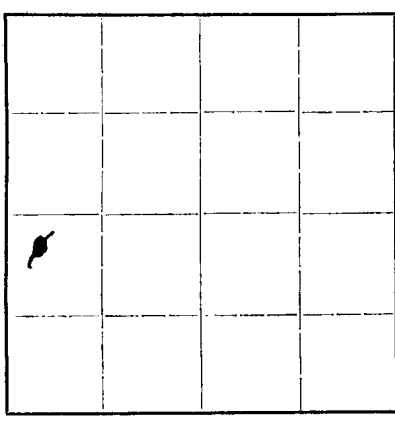

Locate well correctly on above
Section Plat

Russell County. Sec. 21 Twp. 11 Rge. 15 (E) W (W)
Location as "NE $\frac{1}{4}$ NW $\frac{1}{4}$ SW $\frac{1}{4}$ " or footage from lines. NW $\frac{1}{4}$ of NW $\frac{1}{4}$ of SW $\frac{1}{4}$
Lease Owner. H.L. Stuart
Lease Name. Stuart-Spicer Well No. 1
Office Address. Russell, Kansas
Character of Well (completed as Oil, Gas or Dry Hole) Dry Hole
Date well completed. March 8 19. 42
Application for plugging filed. March 19, 1942 19. 42
Application for plugging approved. March 23 19. 42
Plugging commenced. March 20 19. 42
Plugging completed. March 25 19. 42
Reason for abandonment of well or producing formation. Dry Hole
If a producing well is abandoned, date of last production. Dry 19.
Was permission obtained from the Conservation Division or its agents before plugging was commenced? yes

Name of Conservation Agent who supervised plugging of this well. C.T. Alexander, Great Bend, Kansas
Producing formation. None Depth to top. Bottom. Total Depth of Well. 3372 Feet
Show depth and thickness of all water, oil and gas formations.

OIL, GAS OR WATER RECORDS


CASING RECORD

Formation	Content	From	To	Size	Put In	Pulled Out
Sand	20 BWH	295	345	15 $\frac{1}{2}$		
Sand	HFV	350	385	15 $\frac{1}{2}$	400 ft	400 ft
Sand	1 BWH	420	428			
Sand	4 BWH	445	452			
Sand	6 BWH	454	456	12 $\frac{1}{2}$	640 ft	640 ft
Sandy red rock	12 BWH	730	937	10	940 ft	940 ft
Lime-Sandy	2 BWH	2117	2127			
Lime	3 BWH	2525	2527	8 $\frac{1}{2}$	2670 ft	2670 ft

(See reverse hereof)

Describe in detail the manner in which the well was plugged, indicating where the mud fluid was placed and the method or methods used in introducing it into the hole. If cement or other plugs were used, state the character of same and depth placed, from...feet to...feet for each plug set.

From 3372 to 3353, cement plug, placed by dump bailer
From 3352 to 3225 Mud dumped;
From 3225 to 3185 Bridged and cemented-cement placed by dump bailer
From 3185 to 3050 Mud dumped
From 3050 to 2985 Bridged and cemented-cement placed by dump bailer
2985 to 2737-Mud
From 2737 to 2717 Cemented
From 2717 to Bottom of Cellar - Mud
Capped at top with cement

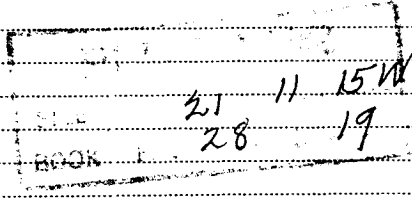

(If additional description is necessary, use BACK of this sheet)

Correspondence regarding this well should be addressed to. H.L. Stuart, Box 73
Address. Russell, Kansas.

STATE OF Kansas, COUNTY OF Russell
H.L. Stuart Operator (employee of owner) or (owner or operator) of the above-described well,
being first duly sworn on oath, says: That I have knowledge of the facts, statements, and matters herein contained and the log of the above-described well as filed and that the same are true and correct. So help me God.

(Signature) H.L. Stuart
Russell, Kansas 4-13-42
(Address)

SUBSCRIBED AND SWORN to before me this 13th day of April, 1942
Charles Boyle
Notary Public.

My commission expires. Feb. 9, 1946

OIL , GAS, OR WATER RECORD (Cont'd)

<u>Formation</u>	<u>content</u>	<u>From</u>	<u>To</u>	<u>Size</u>	<u>Put in</u>	<u>Pulled Out</u>
Lime	HFW	2904	2909			
Lime	1 BWH	3012	3015			
Lime Broken	3 BWH	3036	3038			
Lime	1000 Ft Water	3046	3065	7 In.	3225	3225
Lime	6 BWH	3370	3372	5 In	107	None

Oil or Gas Sands or Zones

Topeka Lime	Show of oil	2731	2733			
K.C. Lime	Show " "	3005	3007			
K.C. Lime	show " "	3040	3046			
K.C. Lime	show of Gas	3195	3201			
K.C. Lime	show of Oil	3228	3230			

15-167-06302-0000

RUSSELL • KANSAS

WELL RECORD

North

Ø			

Location: NW $\frac{1}{4}$ NW $\frac{1}{4}$ SW $\frac{1}{4}$ Sec.21, Twp 11, Rge 15 W.
Russell County, Kansas

Lease Owner: H.L. Stuart, Russell, Kans.
Lease Name : Stuart Spicer #1.
Contractor : H.L. Stuart, Russell, Kans.

Commenced :
Completed : March 8, 1942.

Total Depth: 3372
Character of Well: Completed as Dry Hole
Plugging Commenced: March 20, 1942
Plugging Completed: March 25, 1942

Casing Record

GAS and OIL SHOWS

Size	Set at
15 $\frac{1}{2}$ "	400 ft
12 $\frac{1}{2}$ "	640
10"	940
8 $\frac{1}{4}$ "	2670
7"	3225
5" liner	3330

2731 to 2733
3005 to 3007
3040 to 3046
3195 to 3201 -Smell of Gas
3228 to 3230

Water Sands

295 to 345	20 BWH	2525 to 2527	3BWH
350 to 385	HFV	2904 to 2909	HFV
420 to 428	1 BWH	3012 to 3015	1 BWH
445 to 452	4 BWH	3036 to 3038	3 BWH
454 to 456	6 BWH	3046 to 3065	1000 Ft Water in hole
730 to 937	12 BWH	3370 to 3372	6 BWH
2117 to 2127	2BWH		

21 11 15W
28 19

15-167-06302-0000

Telephone 597-609

H. L. STUART, OIL OPERATOR

Postoffice Box 73

RUSSELL • KANSAS

Figures Indicate Bottom of Formations

<u>Formation</u>	<u>Depth</u>	<u>Formation</u>	<u>Depth</u>
Yellow Clay	25	salt	1512
Lime	32	blue shale	1550
Blue Shale	295	gray shale lime shells	1605
Sand 20 BWH	345	lime	1610
Gray Shale	355	white shale	1625
Blue Shale		lime	1632
Sand HFW	385	shale, lime shells	1645
Red and Gray Shale	410	red rock	1655
Blue Shale	420	gray shale	1695
Sandy Shale 1 BW	428	brown shale	1720
Blue Shale	440	white shale	1740
White Shale	445	red rock	1780
Sand 4 BWH	452	gray shale	1865
Shell Lime	454	lime	1890
Sandy Shale 6 BWH	460	red rock	1900
White Shale	465	lime	1905
Blue Shale	475	white shale	1930
Iron	477	lime	1945
blue shale	481	blue shale	1955
sand water	495	brown shale	1990
blue shale	550	lime	2010
shale, light sandy	580	blue shale	2055
Iron	585	lime	2060
blue shale	598	brown shale	2075
light shale	630	gray shale	2100
red rock	937	red rock	2108
2 BWH at 730'		sandy lime	2127
12 BWH at 800		2 B.W.E. at 2117	
anhydrate	975	blue shale	2150
red shale	985	lime	2175
green shale	995	blue shale	2182
red shale	1085	lime	2200
blue shale	1105	green shale	2206
red shale	1195	lime	2230
gray shale	1220	brown shale	2240
red rock	1235	blue shale, broken lime	2250
light shale	1300	blue shale	2308

21 11 15W
28 19

RUSSELL • KANSAS

Well Log
Spicer No. 1 (Cont'd)

<u>Formation</u>	<u>Depth</u>	<u>Formation</u>	<u>Depth</u>
lime	2318	blue shale	2821
light shale	2355	lime	2918
lime	2359	HFW 2904 to 2909	
blue shale	2395	blue shale	2921
lime	2405	broken lime	2925
brown shale	2415	lime	2957
blue shale	2425	blue shale	2965
lime	2430	red shale	2969
blue shale (Cavy)	2455	Lime (K.C)	2981
lime	2460	blue shale	2988
blue shale	2465	lime	3005
lime	2480	soft lime LSO	3007
gray shale	2500	lime	3019
lime	2504	1 BWH 3012-3015	
gray shale	2523	blue shale	3025
lime	2540	broken lime	3036
blue shale	2560	3 BWH at 3036	
lime	2565	lime	3040
blue shale	2570	soft lime -Showing of	3046
lime	2575	oil	
blue shale	2580	Hole filled	
lime	2582	1000'water	
dark shale	2584	in 2 hrs.	
lime shell	2585		
broken shale	2590	sandy lime -water	3065
lime shells and shale	2598	blue shale	3067
green and brown shale	2605	lime	3069
blue shale	2612	blue shale	3073
lime	2615	lime	3084
blue shale	2622	blue shale	3090
lime	2625	lime	3095
blue shale and lime shell	2650	blue shale	3097
lime	2658	lime	3148
dark shale	2668	blue shale	3154
lime	2670	lime	3164
dark shale	2677	broken lime	3172
lime	2688	blue shale	3175
light shale	2693	lime	3188
lime	2795	black shale	3192
light show of oil		blue shale	3195
2731 to 2733		lime Smell of gas	3201
brown lime	2818	black shale, grainy	3203

21 11 15W
28 19

RUSSELL • KANSAS

Well Log
Spicer No. 1 (Cont'd)

<u>Formation</u>	<u>Depth</u>
lime	3204
blue shale	3210
lime shells	3228
broken lime	3244
lime shells & Blue shale	3265
broken lime	3274
red shale	3277
lime	3280
conglomerate	3286
blue shale	3289
red rock	3292
lime	3294
Conglomerate	3320
red shale	3322
Conglomerate	3350
blue shale	3356
gritty lime-water	3372

Well Plugged and Abandoned at 3372

STATE OF KANSAS , Russell County:SS

I, the undersigned, being duly sworn on oath, depose and state that the above and foregoing well record is true, correct and complete according to the records of this office, and to the best of my knowledge and belief.

H. L. Stuart
Operator

Subscribed and sworn to before me, this 13th. day of April, 1942.

My Commission expires Feb. 9, 1946

Charles Boyle
Notary Public.

21 11 15W
28 19