


15-169-00121-00-80

WELL PLUGGING RECORD

Give All Information Completely
Make Required Affidavit
Mail or Deliver Report to:
Conservation Division
State Corporation Commission
800 Bitting Building
Wichita, Kansas

Saline County. Sec. 22 Twp. 13S Rge. 5W ~~XX~~ (W)
Location as "NE/CNW $\frac{1}{4}$ SW $\frac{1}{4}$ " or footage from lines SE NW SW
Lease Owner National Associated Petroleum Company
Lease Name Pistora Well No. 1
Office Address 5th Floor Ritz Bldg. - Tulsa, Oklahoma
Character of Well (completed as Oil, Gas or Dry Hole) Dry Hole
Date well completed March 18 19 53
Application for plugging filed March 18 19 53
Application for plugging approved March 18 19 53
Plugging commenced March 18 19 53
Plugging completed March 18 19 53
Reason for abandonment of well or producing formation Dry Hole

NORTH

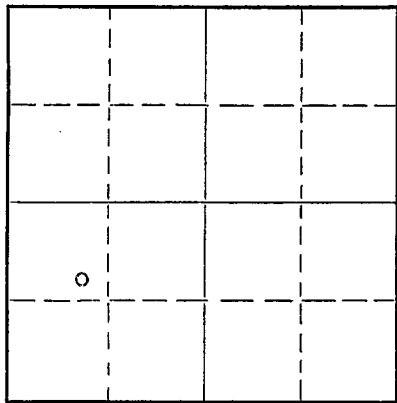

Locate well correctly on above Section Plat

If a producing well is abandoned, date of last production 19
Was permission obtained from the Conservation Division or its agents before plugging was commenced? Yes

Name of Conservation Agent who supervised plugging of this well Ruel J. Durkee
Producing formation Depth to top Bottom Total Depth of Well 3952 Feet
Show depth and thickness of all water, oil and gas formations.

OIL, GAS OR WATER RECORDS

CASING RECORD

Formation	Content	From	To	Size	Put In	Pulled Out
Lansing-Kansas City	Water	2440	3050	10-3/4"	154.20'	None
Mississippian	Water	3089	3400			
Kinderhook	Water	3400	3499			
Hunton	Water	3499	3587			
Waquoketa	Water	3587	3690			
Viola	Water	3690	3830			
Simpson	Water	3830	3885			
Arbuckle	Water	3885	3952			

Describe in detail the manner in which the well was plugged, indicating where the mud fluid was placed and the method or methods used in introducing it into the hole. If cement or other plugs were used, state the character of same and depth placed, from feet to feet for each plug set.

Circulated on bottom for two hours; came out of hole half way; circulated 1/2 hr.; laid down drill pipe; set bridge plug at 153' (bottom of surface pipe); dumped 20 sx cement; filled remainder of hole and set a bridge plug 15 feet from top of surface; dumped 10 sx of cement in top.

03-26-1953

(If additional description is necessary, use BACK of this sheet)

Correspondence regarding this well should be addressed to National Associated Petroleum Company
Address 5th Floor Ritz Bldg. - Tulsa, Oklahoma

STATE OF Oklahoma, COUNTY OF Tulsa, ss.
E. D. Lambeth (employee of owner) or (owner or operator)

being first duly sworn on oath, says: That I have knowledge of the facts, statements, and matters herein contained and the log of the above-described well as filed and that the same are true and correct. So help me God

(Signature) *E. D. Lambeth*
5th Floor Ritz Bldg. - Tulsa, Oklahoma (Address)

SUBSCRIBED AND SWORN to before me this 31st day of March, 19 53.

Maxine O. Province
Notary Public.

My commission expires February 21, 1957

PLUGGING

FILE SEC. 22 T. 13 R. 5W

BOOK PAGE 86 LINE 27

15-169-00121-00-00

NATIONAL ASSOCIATED PETROLEUM COMPANY
PISTORA NO. 1 - SE NW SW of 22-13S-5W
OTTAWA COUNTY, KANSAS

Drilling Contractor: Exploration Drilling Co.
220 North Boston
Tulsa, Oklahoma

Started Rigging Up : 2-27-53
Started Drilling : 2-28-53
Completed Drilling : 3-17-53

Set: 5 Joints of 10-3/4" Surface Casing
@ 163' W/150 Sacks of Cement.

FORMATIONS

Surface	0'	60'
Shale & Sand Strks.	60	163
Sand	163	500
Lime & Shale	500	2030
Lime, Shale & Chert Stks.	2030	2137
Lime & Shale	2137	2210
Lime & Shale Stks.	2210	2303
Lime & Shale	2303	2370
Shale & Lime Stks.	2370	2475
Shale & Lime	2475	2691
Shale & Hard Lime	2691	2747
Lime & Shale	2747	3024
Lime, Shale & Chert	3024	3150
Lime & Shale	3150	3196
Lime, Chert & Shale	3196	3255
Hard Lime, Chert & Shale	3255	3297
Lime & Chert	3297	3375
Lime & Shale	3375	3498
Lime, Shale & Chert	3498	3509
Lime & Shale	3509	3546
Lime & Chert	3546	3651
Lime & Shale	3651	3703
Shale & Lime Stks.	3703	3725
Lime & Shale	3725	3758
Shale & Lime Stks.	3758	3824
Lime & Shale	3824	3865
Lime, Shale & Chert	3865	3942
Lime & Shale	3942	3950 Total Depth

CERTIFICATION

This is to certify that the above and foregoing is a true, correct, and complete copy of the Driller's Log covering the Pistora No. 1 according to the records of this office and the best of my knowledge and belief.

RECEIVED
STATE CORPORATION COMMISSION

APR 8 - 1953
04-08-1953
CONSERVATION DIVISION
Wichita, Kansas

EXPLORATION DRILLING COMPANY

By George M. Lee
Notary Public

PLUGGING
FILE SEC 22-T-13-R-5W
BOOK PAGE 86-LINE 27

Subscribed and sworn to before me this 3rd day of April, 1953.

My commission expires April 25, 1954.