


WELL PLUGGING RECORD

Give All Information Completely
Make Required Affidavit
Mail or Deliver Report to:
Conservation Division
State Corporation Commission
211 No. Broadway
Wichita, Kansas

NORTH

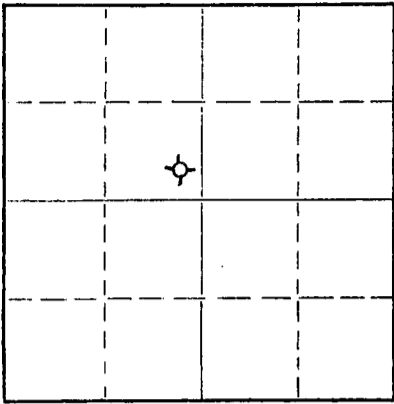

Locate well correctly on above Section Plat

Saline County. Sec. 13 Twp. 13 Rge. 4W (E) (W)
Location as "NE/CNW/SW" or footage from lines SE SE NW
Lease Owner C-G Drilling Co. & N. Appleman Co.
Lease Name Weiss Well No. 1
Office Address 107 Rule Building, Wichita 2, Kansas
Character of Well (completed as Oil, Gas or Dry Hole) Dry Hole
Date well completed September 16 19 59
Application for plugging filed September 16 19 59
Application for plugging approved September 16 19 59
Plugging commenced September 16 19 59
Plugging completed September 16 19 59
Reason for abandonment of well or producing formation Too low structurally

If a producing well is abandoned, date of last production 19
Was permission obtained from the Conservation Division or its agents before plugging was commenced? Yes

Name of Conservation Agent who supervised plugging of this well Eldon Petty, Hays, Kansas
Producing formation _____ Depth to top _____ Bottom _____ Total Depth of Well 3781 Feet
Show depth and thickness of all water, oil and gas formations.

OIL, GAS OR WATER RECORDS

CASING RECORD

FORMATION	CONTENT	FROM	TO	SIZE	PUT IN	PULLED OUT
				8-5/8"	237'	None

Describe in detail the manner in which the well was plugged, indicating where the mud fluid was placed and the method or methods used in introducing it into the hole. If cement or other plugs were used, state the character of same and depth placed, from _____ feet to _____ feet for each plug set.

Filled hole with heavy mud to 225'. Set plug. Put in 20 sacks cement. Filled to 40'. Set plug. Put in 10 sacks cement. 2 sacks cement in rat hole.

RECEIVED
STATE CORPORATION COMMISSION
SEP 24 1959
09-24-1959
CONSERVATION DIVISION
Wichita, Kansas

(If additional description is necessary, use BACK of this sheet)
Name of Plugging Contractor Mallard Drilling Company
Address Union National Building, Wichita, Kansas

STATE OF KANSAS, COUNTY OF SEDGWICK, ss.
G. F. Galloway (employee of owner) or (owner or operator) of the above-described well, being first duly sworn on oath, says: That I have knowledge of the facts, statements, and matters herein contained and the log of the above-described well as filed and that the same are true and correct. So help me God.

(Signature) G. F. Galloway
107 Rule Building
(Address)

SUBSCRIBED AND SWORN TO before me this 23rd day of September, 1959

My commission expires May 20, 1963

Vicky Jacobs
Notary Public.

PLUGGING

File Sec. 13 T. 13 R. 4W
Book Page 4 Line 23

15-169-00187-00-00

COMPANY: C-G Drilling Company
 CONTRACTOR: Mallard Drilling Company
 FARM: Pearl Weiss #1
 LOCATION: SE SE NW/4 Sec. 13-13-4W
 Saline County, Kansas
 COMMENCED: September 5, 1959
 COMPLETED: September 16, 1959

0	to	40	Sand
40	to	235	Shale and lime
235	to	450	Lime
450	to	800	Lime
800	to	1160	Lime and shale
1160	to	1795	Lime and shale
1795	to	2075	Lime
2075	to	2275	Sand and shale
2275	to	2310	Lime and shale
2310	to	2560	Lime
2560	to	2940	Shale and lime
2940	to	2986	Lime and shale
2986	to	3015	Mississippi
3015	to	3095	Mississippi Lime
3095	to	3205	Lime and chert
3205	to	3320	Lime
3320	to	3434	Shale
3434	to	3485	Chert and lime
3485	to	3620	Shale and lime
3620	to	3730	Lime
3730	to	3770	Shale and sand
3770	to	3781	Simpson sand
		3781	T.D. Rotary

RECEIVED
 STATE CORPORATION COMMISSION
 SEP 24 1959
 09-24-1949
 CONSERVATION DIVISION
 Wichita, Kansas

Set 235 ft. 8 5/8" surface pipe. Cemented with 150 sacks cement.
 TOPS: K.C. --2310 Miss.--2986 Hunt.--3434 Mq. -- 3534 Viola --3633
 Simpson --3730

DRY**ABANDONED--PLUGGED

Measurements taken from R.D.B. R.D.B. 5 1/2 ft. from ground level.

C E R T I F I C A T E

I, C. C. Nelson, do hereby certify that the above and foregoing is a true and correct copy of log of the Weiss #1, Saline County, Kansas as reflected by files of the Mallard Drilling Company.

C. C. Nelson

Subscribed and sworn to before me a Notary Public, within and for Sedgwick County, Kansas, this 16th day of September 1959.

Edward D. Sear

My commission expires March 12, 1959

PLUGGING

File Sec. 13 T 13 R 4W
 Book Page 4 Line 23