


WELL PLUGGING RECORD

Give All Information Completely  
Make Required Affidavit  
Mail or Deliver Report to:  
Conservation Division  
State Corporation Commission  
800 Bitting Building  
Wichita, Kansas

Comanche County, Sec. 15 Twp. 34 Rge. (E) 20 (W)

Location as "NE/CNW/SW" or footage from lines C SW/4 of NW/4  
Lease Owner M.B. Armer & Dutch George Drilling, Inc.  
Lease Name Lemon-Barbee Well No. 1  
Office Address 505 Petroleum Building, Wichita, Kansas  
Character of Well (completed as Oil, Gas or Dry Hole) Dry Hole  
Date well completed 7/4 19 55  
Application for plugging filed 7/4 19 55  
Application for plugging approved 7/4 19 55  
Plugging commenced 7/4 19 55  
Plugging completed 7/4 19 55  
Reason for abandonment of well or producing formation Dry

NORTH

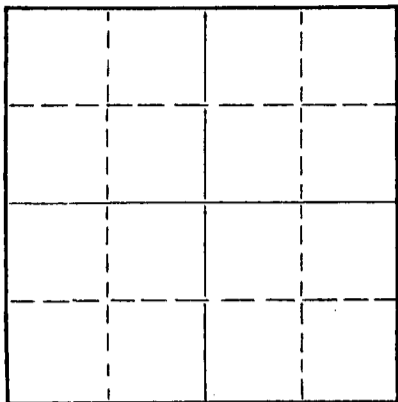

Locate well correctly on above Section Plat

If a producing well is abandoned, date of last production 19  
Was permission obtained from the Conservation Division or its agents before plugging was commenced? Yes

Name of Conservation Agent who supervised plugging of this well M.A. Rives  
Producing formation Depth to top Bottom Total Depth of Well Feet  
Show depth and thickness of all water, oil and gas formations.

OIL, GAS OR WATER RECORDS

CASING RECORD

FORMATION	CONTENT	FROM	TO	SIZE	PUT IN	PULLED OUT
				13-3/8"	85'	None
				8-5/8"	504'	None

Describe in detail the manner in which the well was plugged, indicating where the mud fluid was placed and the method or methods used in introducing it into the hole. If cement or other plugs were used, state the character of same and depth placed, from feet to feet for each plug set.

Filled hole with mud to 500'. Set plug and ran 25 sacks with dump bailer filled with mud to 35'. Set Plug and 15 sacks of cement to surface.

(If additional description is necessary, use BACK of this sheet)

Name of Plugging Contractor Dutch George Drilling, Inc.  
Address 505 Petroleum Building, Wichita, Kansas.

STATE OF Kansas, COUNTY OF Sedgwick, ss.  
J. S. George (employee of owner) or (owner or operator) of the above-described well, being first duly sworn on oath, says: That I have knowledge of the facts, statements, and matters herein contained and the log of the above-described well as filed and that the same are true and correct. So help me God.

(Signature) J. S. George  
505 Petroleum Building, Wichita, Kansas  
(Address)

SUBSCRIBED AND SWORN TO before me this 8th day of July, 19 55

Pauline Arnett  
Notary Public.

My commission expires

7-12-55

**PLUGGING**  
FILE SEC 15 T 34 R 30  
BOOK PAGE 131 LINE 30

**KANSAS GEOLOGICAL SOCIETY**  
 KANSAS WELL LOG BUREAU - KANSAS WELL SAMPLE BUREAU  
 KANSAS GEOLOGICAL SOCIETY BUILDING  
 508 EAST MURDOCK - WICHITA, KANSAS


15-033-00042-0000

COMPANY **Dutch George Drilling, Inc.**  
 FARM **Lamm-Barbee** NO. **1**

SEC. **35** T. **34** R. **20W**  
 LOC. **C 20 20**

TOTAL DEPTH **5310**  
 COMM. **6/9/55** COMP. **7/4/55**  
 SHOT OR TREATED  
 CONTRACTOR **Dutch George Drilling, Inc.**  
 ISSUED

 KANSAS

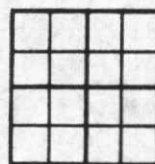

CASING  
 20 10  
 15 8 **504'**  
 12 6  
 13 **85'** 5

ELEVATION **1769 W**  
**1772 W**

PRODUCTION

FIGURES INDICATE BOTTOM OF FORMATIONS

Sand and Red Bed	156
Red Bed	504
Sandy lime Red Bed	785
Shale & Red Bed	1100
Shale & lime	1635
Shale & lime, Salty	2050
lime, Anhydrite	2265
Hard lime	2342
lime	2432
lime & shale	2565
lime & shale, sandy	2815
shale and lime	3030
shale	3205
shale and lime	3520
lime	3525
lime & shale	3775
sand and shale	4095
shale & lime	4311
sandy shale	4434
lime	4585
lime	4670
shale and lime	4839
lime	4916
lime & shale	4942
lime	5004
lime & shale	5161
chert	5278
lime & chert	5301
lime	5310

**Formation Feet**

Hester	4152
Lansing EC	4337
Base EC	4785
Harrison	4875
Cherokee	5010
Mississippi	5160

I hereby certify that this is a true and correct log of the above described well as shown by the drilling reports.

DUTCH GEORGE DRILLING, INC.

BY *J. B. George*

STATE OF KANSAS )  
 COUNTY OF OSAGE ) SS:

Subscribed and sworn to before me, a notary public, in and for said County and State this 8<sup>th</sup> day of July, 1955.



PAULINE ARNETT  
 commission expires Feb. 26, 1959

*Pauline Arnett*  
 Notary Public

RECEIVED  
 STATE CORPORATION COMMISSION

JUL 12 1955

CONSERVATION DIVISION  
 Wichita, Kansas

**PLUGGING**  
 FILE SEC 15 T 34 R 20W  
 BOOK PAGE 13 LINE 20