STATE OF KANSAS
STATE CORPORATION COMMISSION
200 Colorado Derby Building
Wichita, Kansas 67202

WELL PLUGGING RECORD
K.A.R.-82-3-117

API NUMBER 15-033-20887-0002

LEASE NAME Selzer

WELL NUMBER 16-4

TYPE OR PRINT
NOTICE: Fill out completely and return to Cons. Div. office within 30 days.

1665 Ft. from S Section Line

2365 Ft. from E Section Line

LEASE OPERATOR Samuel Gary Jr. & Asso.

SEC. 16 TWP. 34 RGE. 20 (E) or (W)

ADDRESS 1670 Broadway, Suite 3300 Denver Co. 80202

COUNTY commanche

10-28-98

PHONE # (303) 831-4673 OPERATORS LICENSE NO. 3882

Date Well Completed

Character of Well good

Plugging Commenced 10-10-98

(Oil, Gas, D&A, SWD, Input, Water Supply Well)

Plugging Completed 10-22-98

The plugging proposal was approved on 10-10-98 10-28-98 (date)

by Steve Middelton (KCC District Agent's Name).

Is ACO-1 filed? If not, is well log attached?

Producing Formation Miss& KC Depth to Top 4323 Bottom 5214 T.D. CIBP 5260

Show depth and thickness of all water, oil and gas formations.

OIL, GAS OR WATER RECORDS | CASING RECORD

Formation	Content	From	To	Size	Put in	Pulled out
				8 5/8	712	0
				20	40	0
				5 1/2	6486	3800

Describe in detail the manner in which the well was plugged, indicating where the mud fluid was placed and the method or methods used in introducing it into the hole. If cement or other plugs were used, state the character of same and depth placed, from feet to feet each set.

MIRU lay down rods& tbg. set CIBP @ 4275 dump 2 sxs cement with dump bailer stretch &cut pipe @ 3700 lay down csg. RDMO MIRU Allied & pump 300# csh 10 jel ,50 cement, 10 jel, 100# csh 8 5/8 wiper, & 150 sxs cement 60 40 6% jel RDMO

(If additional description is necessary, use BACK of this form.)

Name of Plugging Contractor Clarke Corporation License No. 5105

Address P.O. Box 187, Medicine Lodge, KS 67104

NAME OF PARTY RESPONSIBLE FOR PLUGGING FEES: Sam Gary JR

STATE OF Kansas COUNTY OF Barber, ss.

Alan Vratil (Employee of Operator) or (Operator) of the above-described well, being first duly sworn on oath, says: That I have knowledge of the facts statements, and matters herein contained and the log of the above-described well as filed that the same are true and correct, so help me God.

(Signature)

(Address) Medicine Lodge, KS 67104

SUBSCRIBED AND SWORN TO before me this 23rd day of October, 19 98

NOTARY PUBLIC - State of Kansas
CAREN J. WINCHELL
My Appt. Exp.

Notary Public

My Commission Expires: 6-21-99

Form CP-
Revised 05-8

Selzer 16-4 Current Completion

SPUDDED 5/6/94
API # 15-033-20887-0002
OIL WELL ON 320 PUMPING UNIT
PRODUCING FROM LANSING/KC AND MISSISSIPPIAN

LOCATION:
1665 FNL/2365 FEL
SEC 16, T34S, R20W
COMMANCHE COUNTY, KANSAS
KB = 1768' GL = 1755'

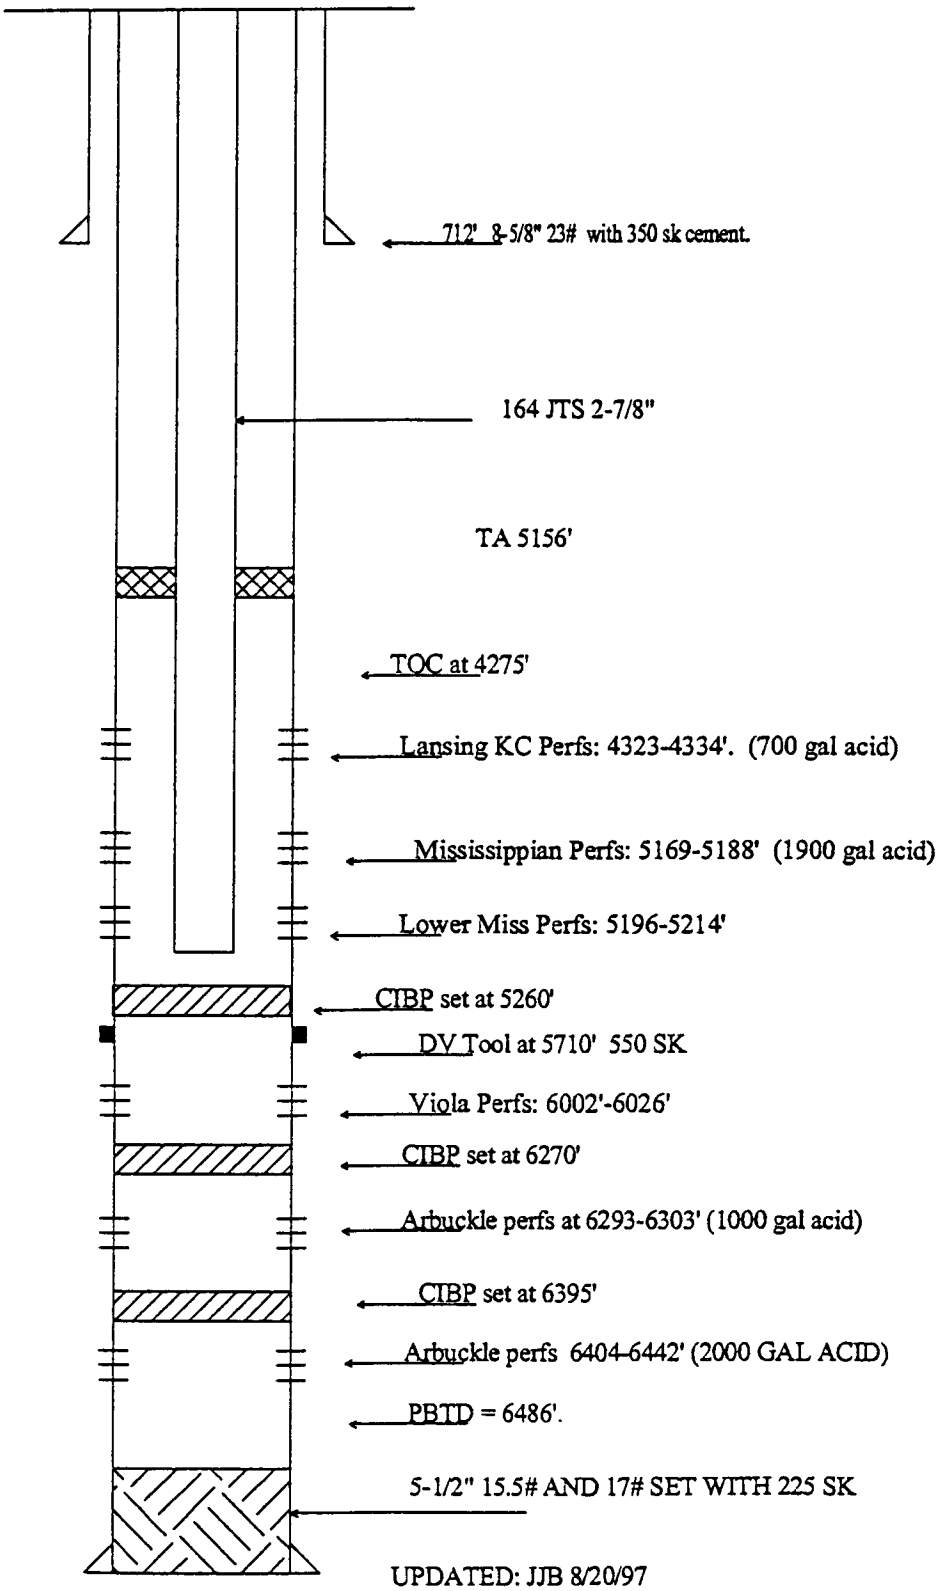

UPDATED: JJB 8/20/97

DTD = 6501'

LTD = 6504'